

OR 19

R.B. Monument No. 2.
& S.W. Emigrant.

State Hwy. 395

80°

Tavern.

S.W. 23rd St.
30'

RESERVATION BOUNDARY
S.W. 23rd St. 30'

Detail Showing
Position and location
of Tavern on
Tract No. 2.
Scale 1 inch = 40 feet.

50.01	100	60
12	29	5
"	11	6
"	10	7
50.01	9	8

50.01	100	100
12	38	5
"	11	6
"	10	7
50.01	9	8

S.W. 22nd St.

9-212-1A


- 27-0-57'
- 54-1-14'
- 86-1-51'
- 108-2-28'
- 135-3-05'
- 142-3-42'
- 187-4-19'

R.B. Monument No. 2

S.W. E. MIGRANT AVE.

50.01	30	30
14	1	
"	13	2
"	12	3
"	11	30
"	10	5
"	9	6
50.01	8	7
		100

50.01	30	30
14	1	
"	13	2
"	12	3
"	11	94
"	10	5
"	9	6
50.01	8	7
		100

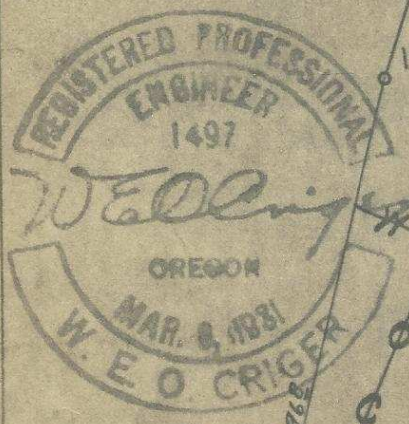

N 90° 55' W 827.70
S.E. Cor. Sec. 9

N 9° 41' W 396.68
Δ 8° 46' (Wrong)

Plat Showing
Two descriptive tracts in the
N.E. 4 of S.E. 4 of Sec. 9, T.2N., R.32 E.W.M.
Surveyed, Staked and Platted, Oct. 1947.
By W.E.O. Criger, Ore. Reg. C.E. No. 1497.
Scale: 1 inch = 100 Ft.

9-212-1A