


Q-217-Ax

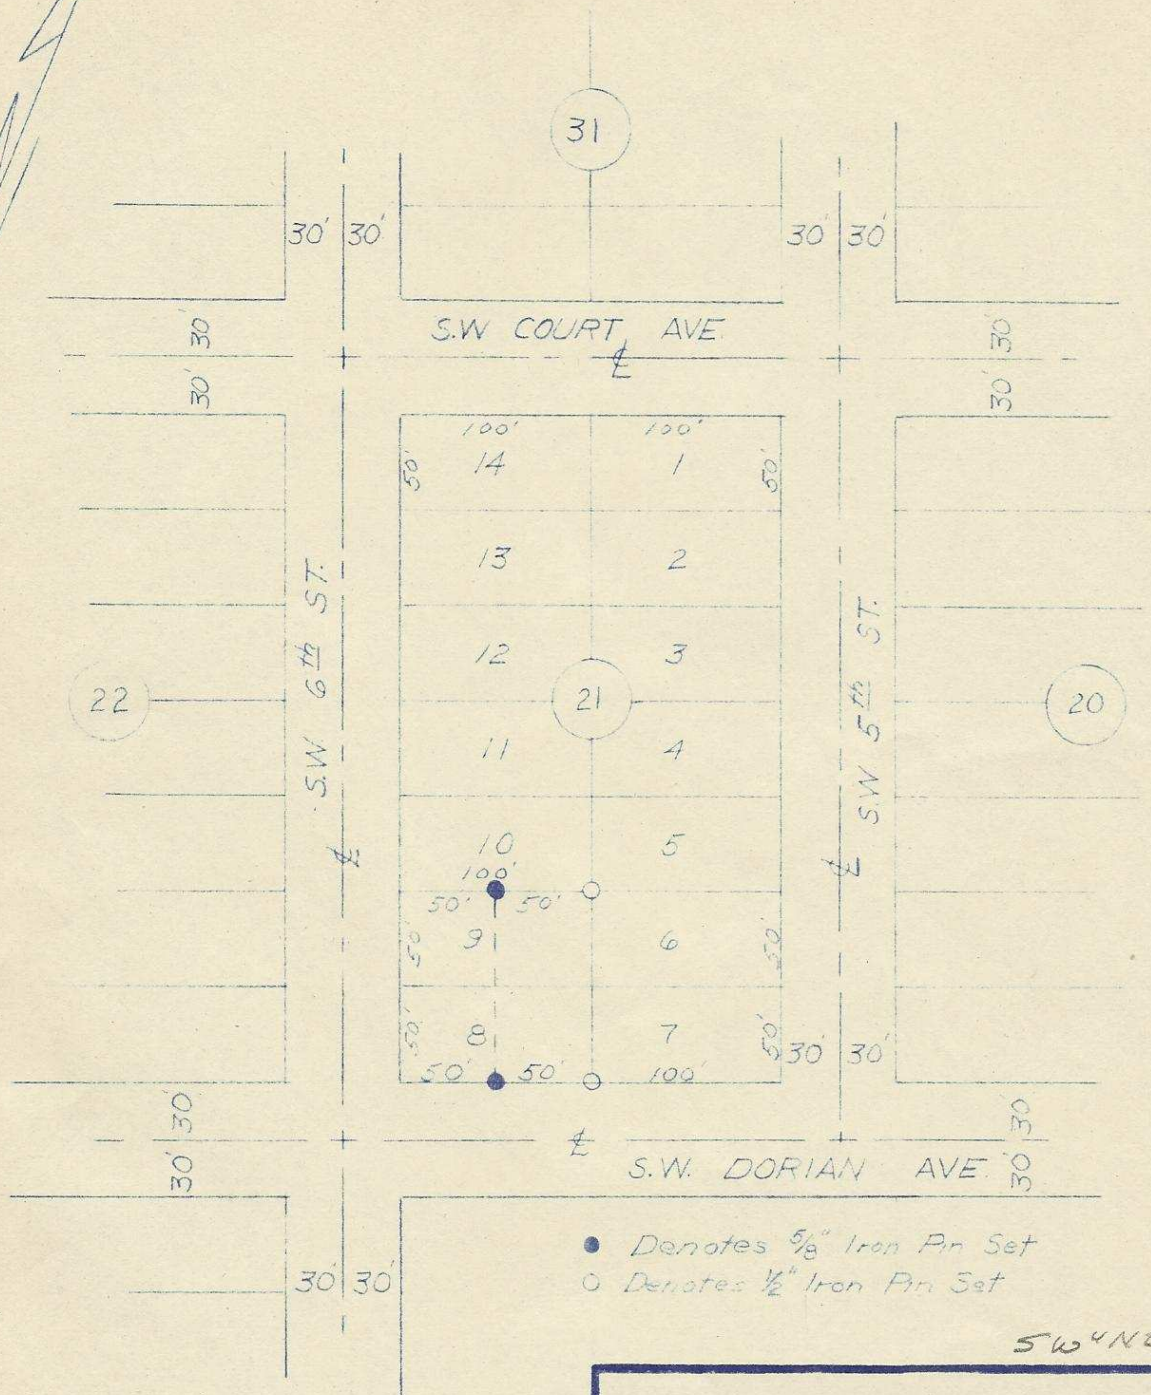

- Denotes 5/8" Iron Pin Set
- Denotes 1/2" Iron Pin Set

SW 4 NE 10

REGISTERED
OREGON
LAND SURVEYOR

Wayne & Harris
MAY 4 1962

WAYNE O. HARRIS
346

HAYES AND HARRIS

SURVEY FOR

GRACE WORTHINGTON

E 1/2 LOTS 8 & 9

BLOCK 21

RESERVATION
PENDLETON,

ADDITION
OREGON Q-217-Ax

| | | | |
|---------|---------|---------|----------|
| SCALE | DATE | DRN. BY | DRN. NO. |
| 1"=100' | 8/10/61 | L.H.A. | 61-159 |

ORA7

195