


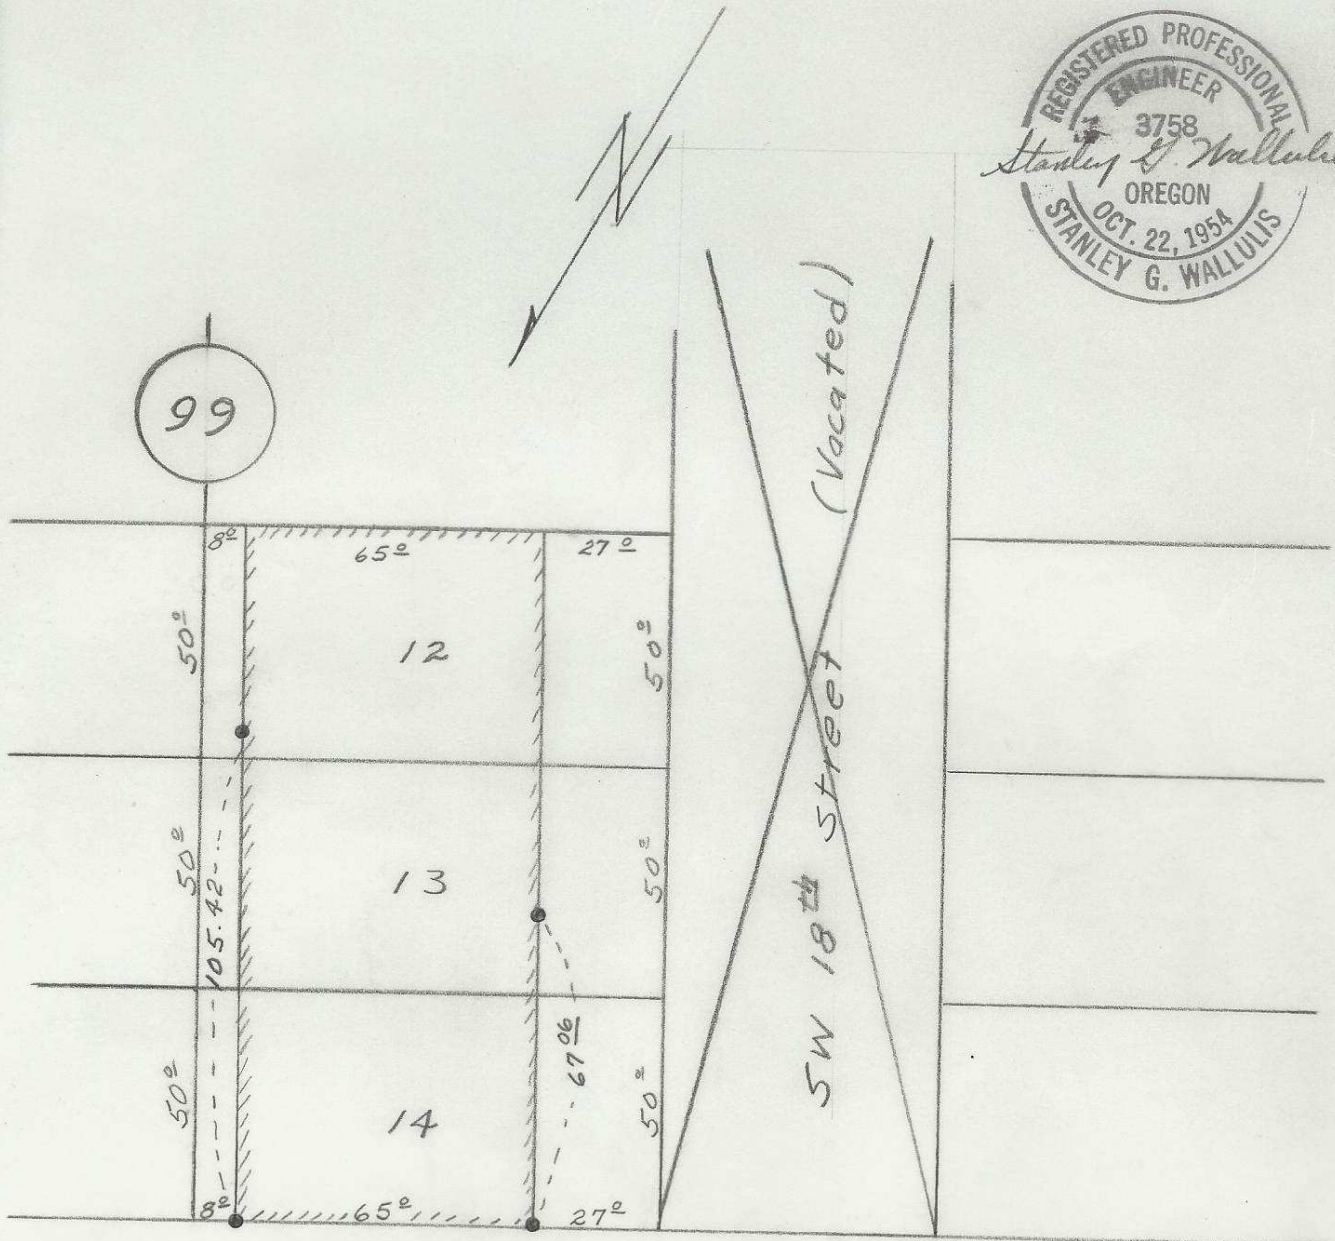

99



SW FRAZER AVE 60°

60°

Survey for Waldo Carr

SCALE: 1" = 40' DATE: 4-16-56

WALL AND TENNESON
Engineers

The Dalles Oregon

Q-254-AX
2N 32 10CB