


E N.W. CARDEN AVE. ↘

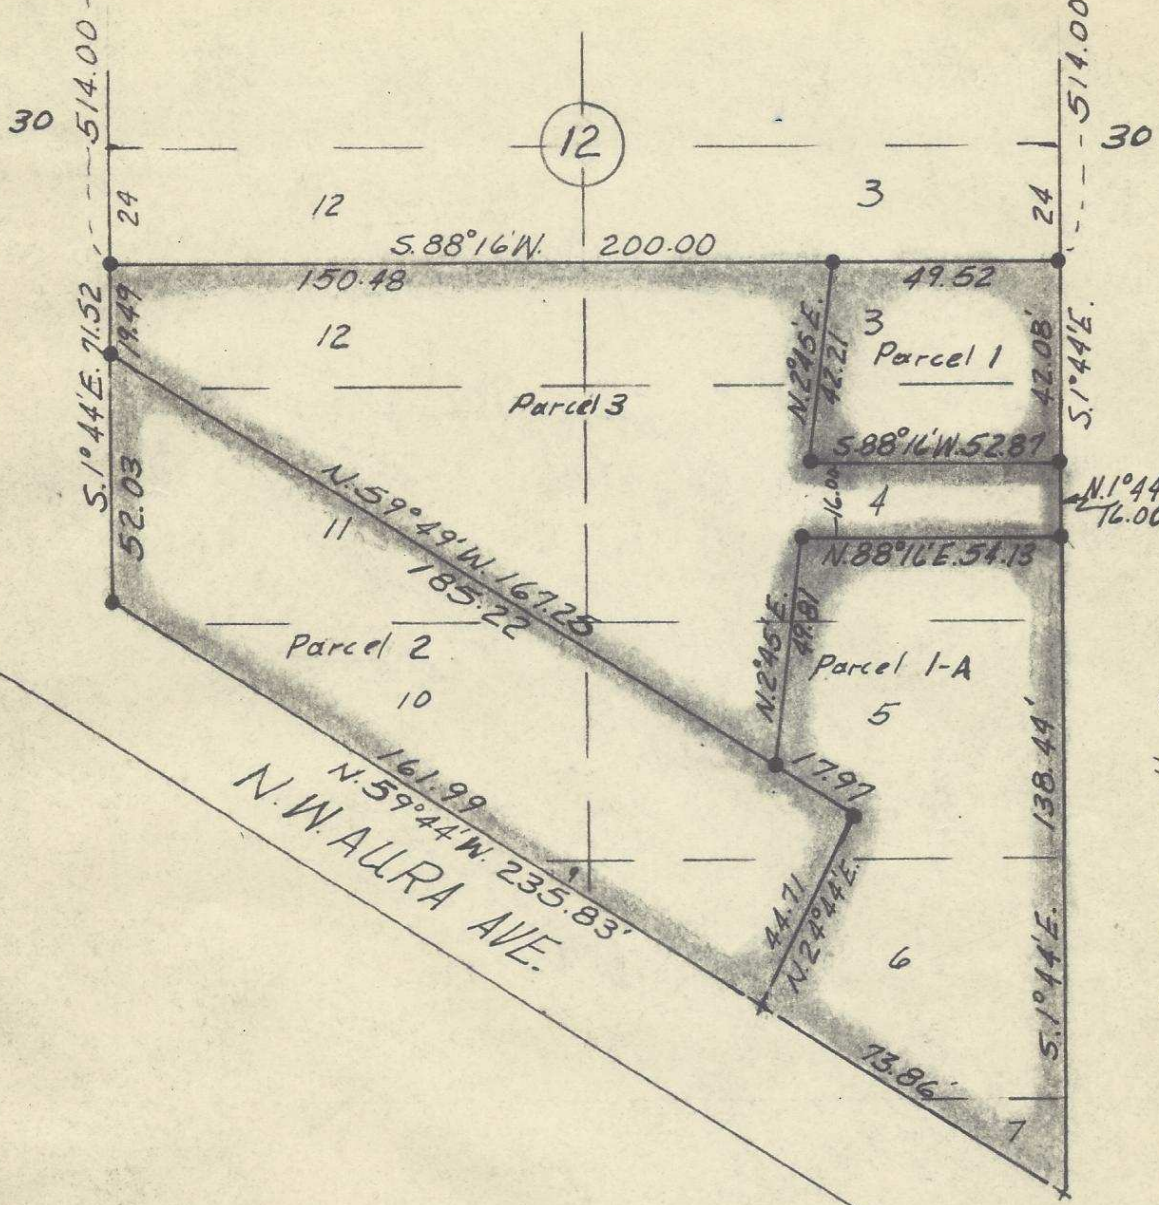

E N.W. 11th



E N.W. 10th ↘

"●" Indicates Iron Pins set
 "+" Indicates plus in Sidewalk

REGISTERED
OREGON
 LAND SURVEYOR

Ralph P. Thompson

MAY 13, 1960
 RALPH P. THOMPSON
 506

Q-301-Ax

2N32 10BA
 Property Survey
 IN BLK. 12 HOUSES ADD.
 Pendleton Oregon

Date: 4-13-65 Scale: 1" = 40'

R. P. THOMPSON
 REGISTERED PROFESSIONAL LAND SURVEYOR
 13 S. E. COURT AVE. PENDLETON, OREGON