


Q-401-Ax

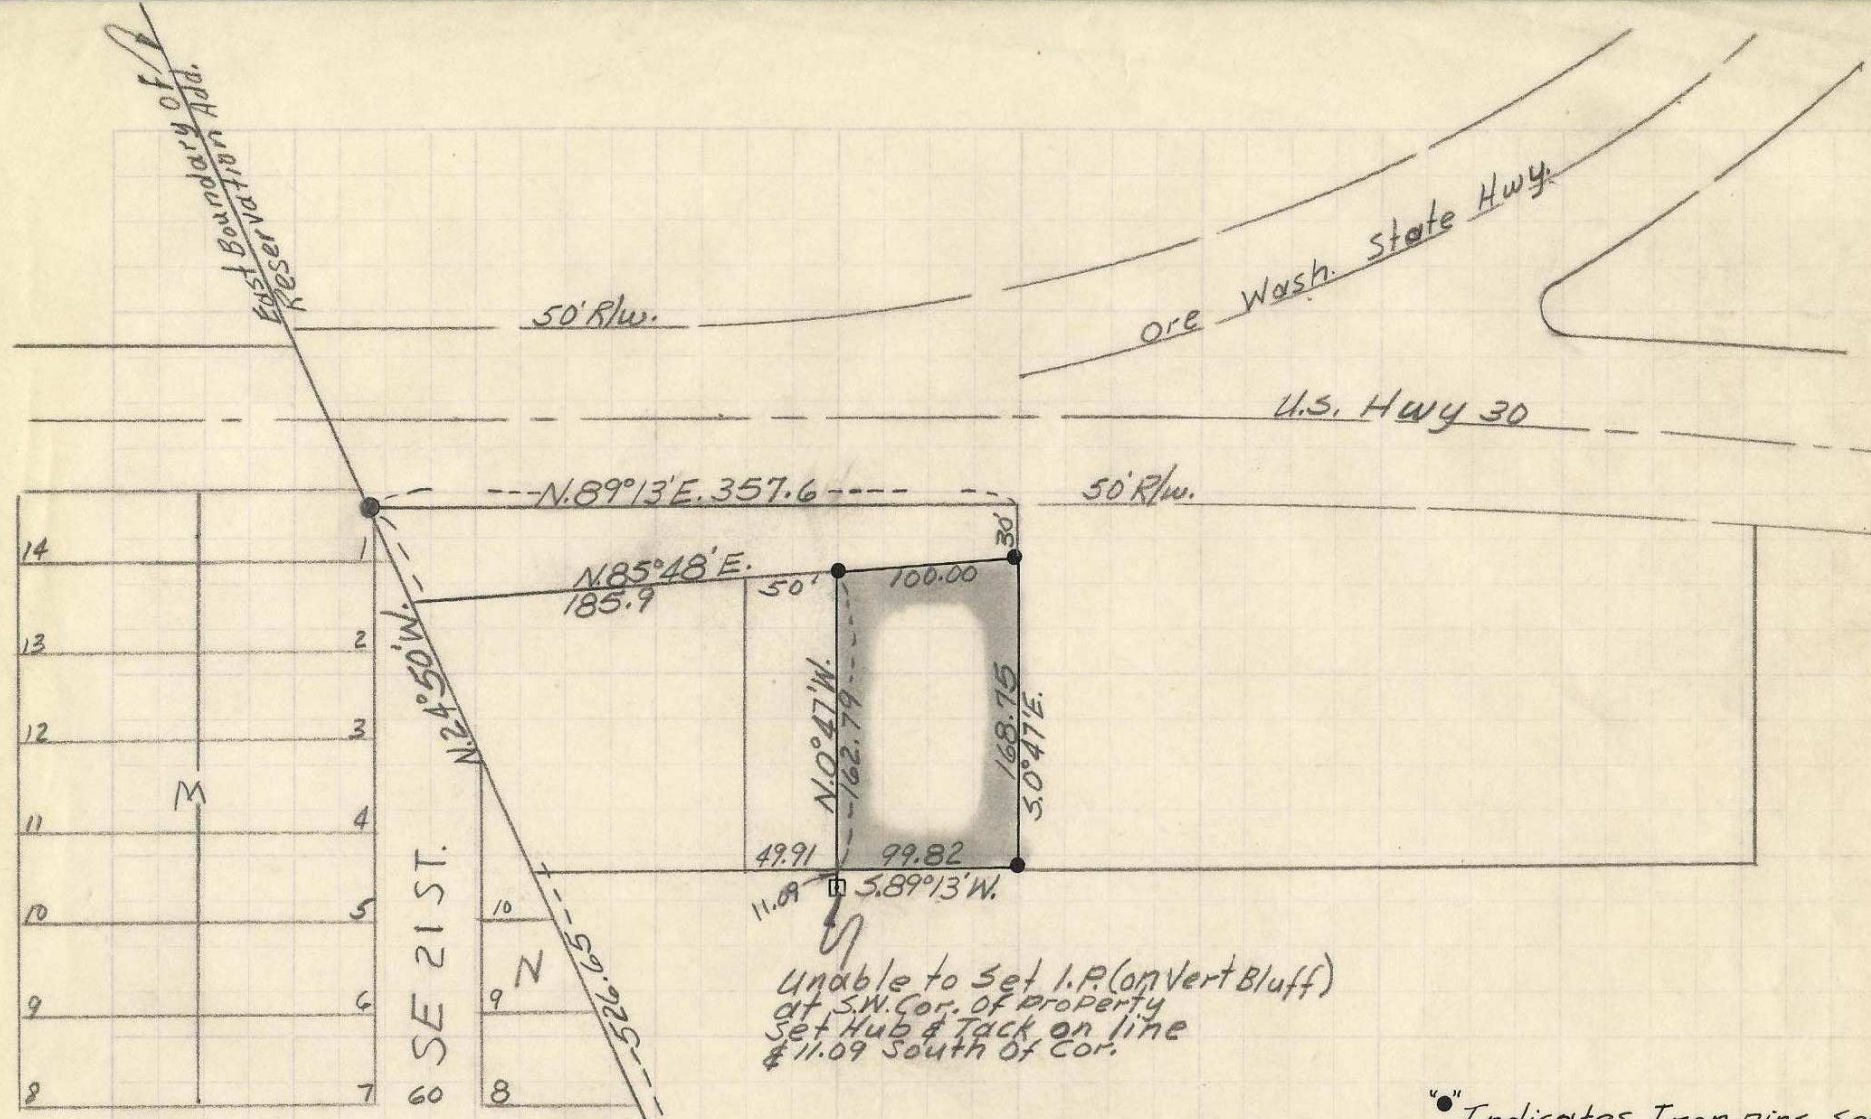

Unable to set I.P. (on Vert Bluff)  
 at S.W. Cor. of property  
 Set Hub & Tack on line  
 & 11.09 South of Cor.

• Indicates Iron pins set  
 Q-401-Ax

Property Survey For  
**JACK STANGIER**  
 In NW 1/4 Sec. 12, T.2N. R.32E. W.M.

Date: 4-21-63 Scale: 1"=100'

Ralph P. Thompson  
 Land Surveying  
 Pendleton, Ore.

REGISTERED  
**OREGON**  
 LAND SURVEYOR

Ralph P. Thompson

MAY 13, 1960  
 RALPH P. THOMPSON  
 506

Mon. #13 To  
 The Reservation  
 Addition

SE. Goodwin Ave.

East Boundary of  
 Reservation Add.