


B-434-AX
orig

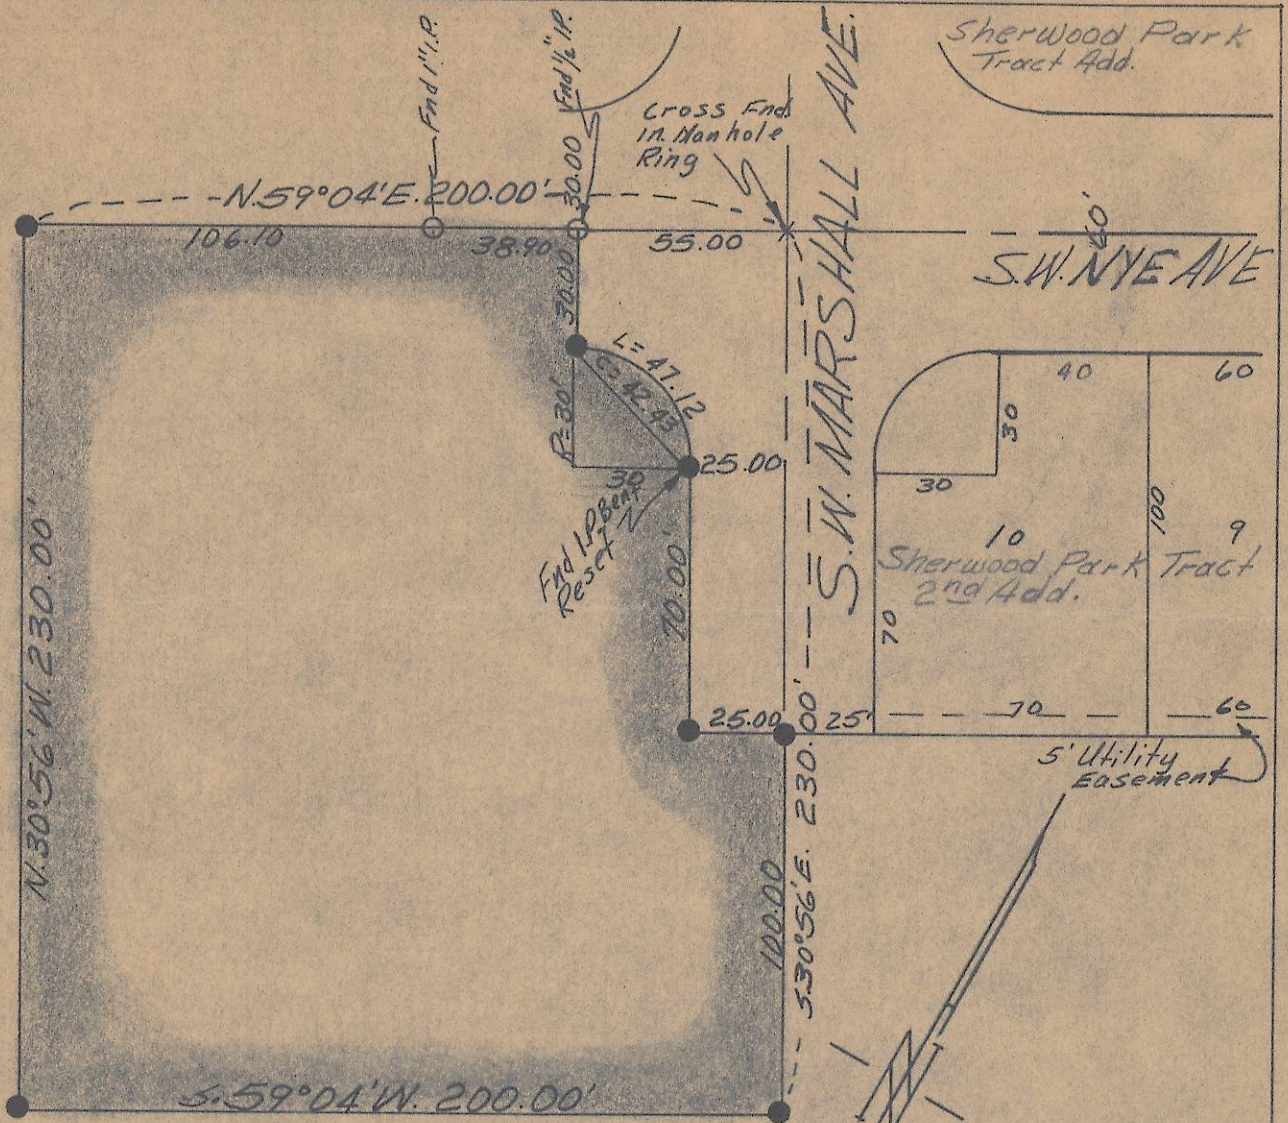

REGISTERED
OREGON
LAND SURVEYOR

Ralph P. Thompson

1961

RALPH P. THOMPSON

208

"o" Indicates Iron pins Found
"●" Indicates Iron pins Set

Property Survey For
THE FIRST BAPTIST CH.
loc. in E 1/2 Sec. 16 T2N. R32E W4

Date: 10/15/62 Scale: 1" = 50'

Ralph P. Thompson
Land Surveying
Pendleton, Ore.

SW 1/4 NE 16