
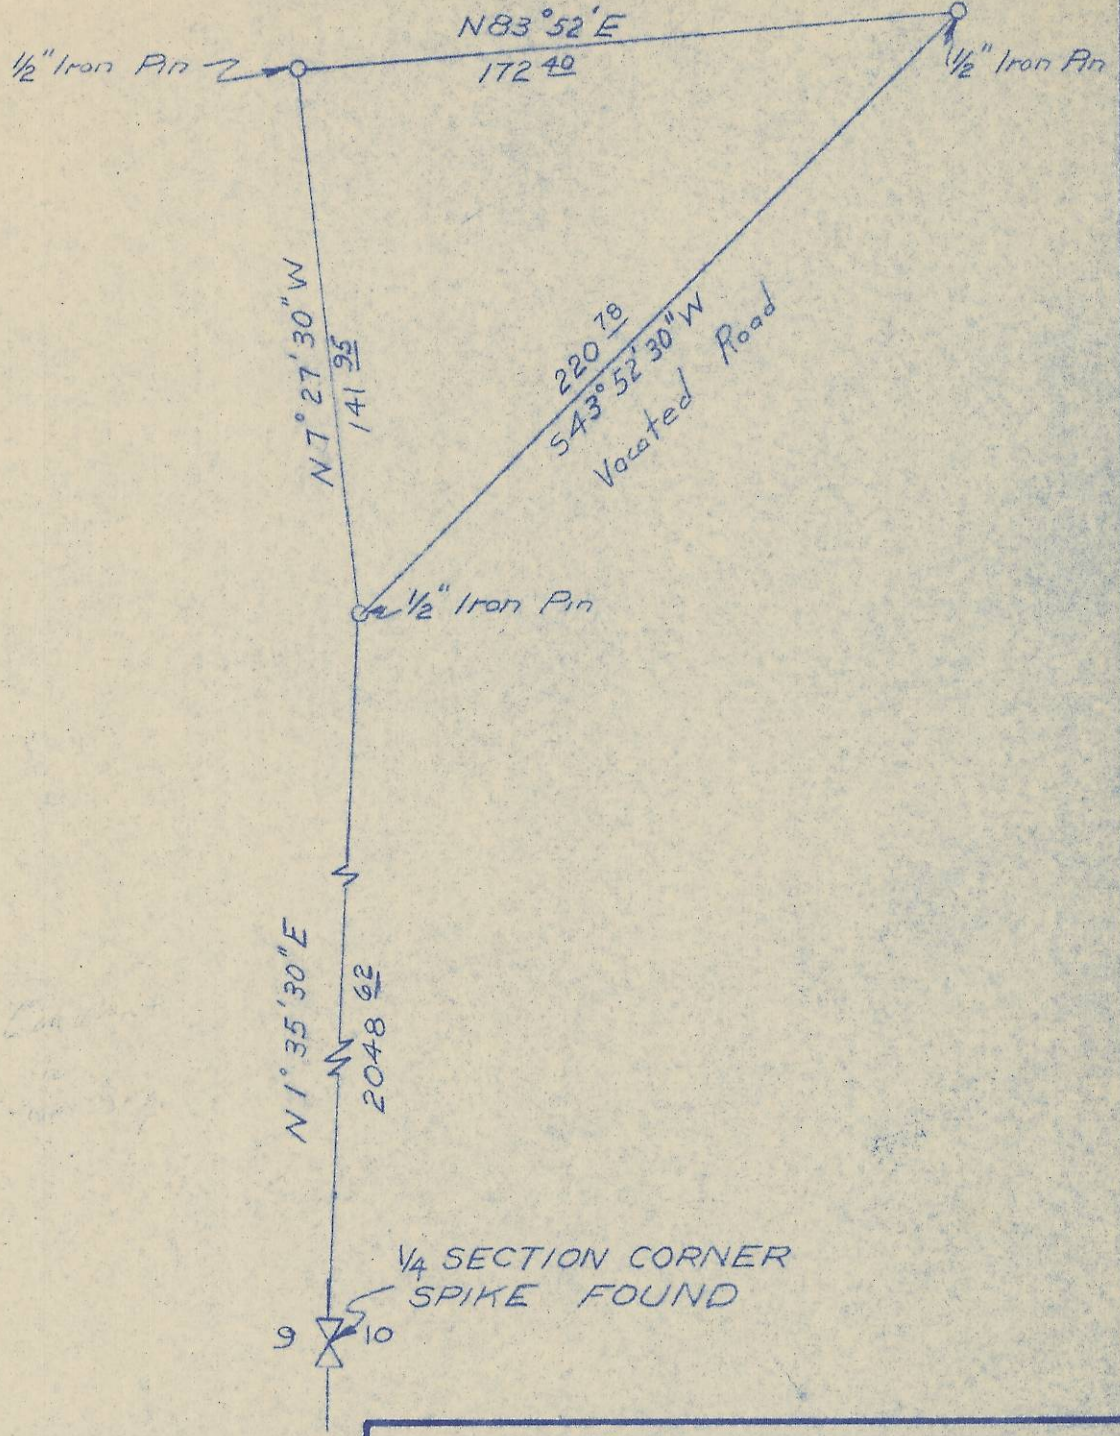


Mig.
Q-478-Ax

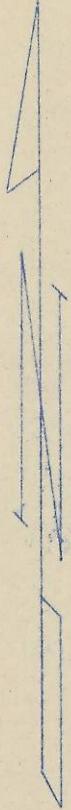

REGISTERED
OREGON
LAND SURVEYOR

Wayne O. Harris

MAY 5, 1955
WAYNE O. HARRIS
346

HAYES AND HARRIS			
SURVEY FOR RAYMOND ANDERSON			
PARCEL IN THE NW $\frac{1}{4}$, SECTION 10, T. 2 N., R. 33 E., W.M.			
SCALE	DATE	DRN. BY	DRNG. NO.
1"=50'	6/30/62	L.H.A.	62-17)

941