

Q-647-Ax


L A MOORE THEATER SITE  
In Block 8, Hermiston, Ore

Scale 1" = 50'

SEW

Verl R. H. Haley  
6.14.49

11

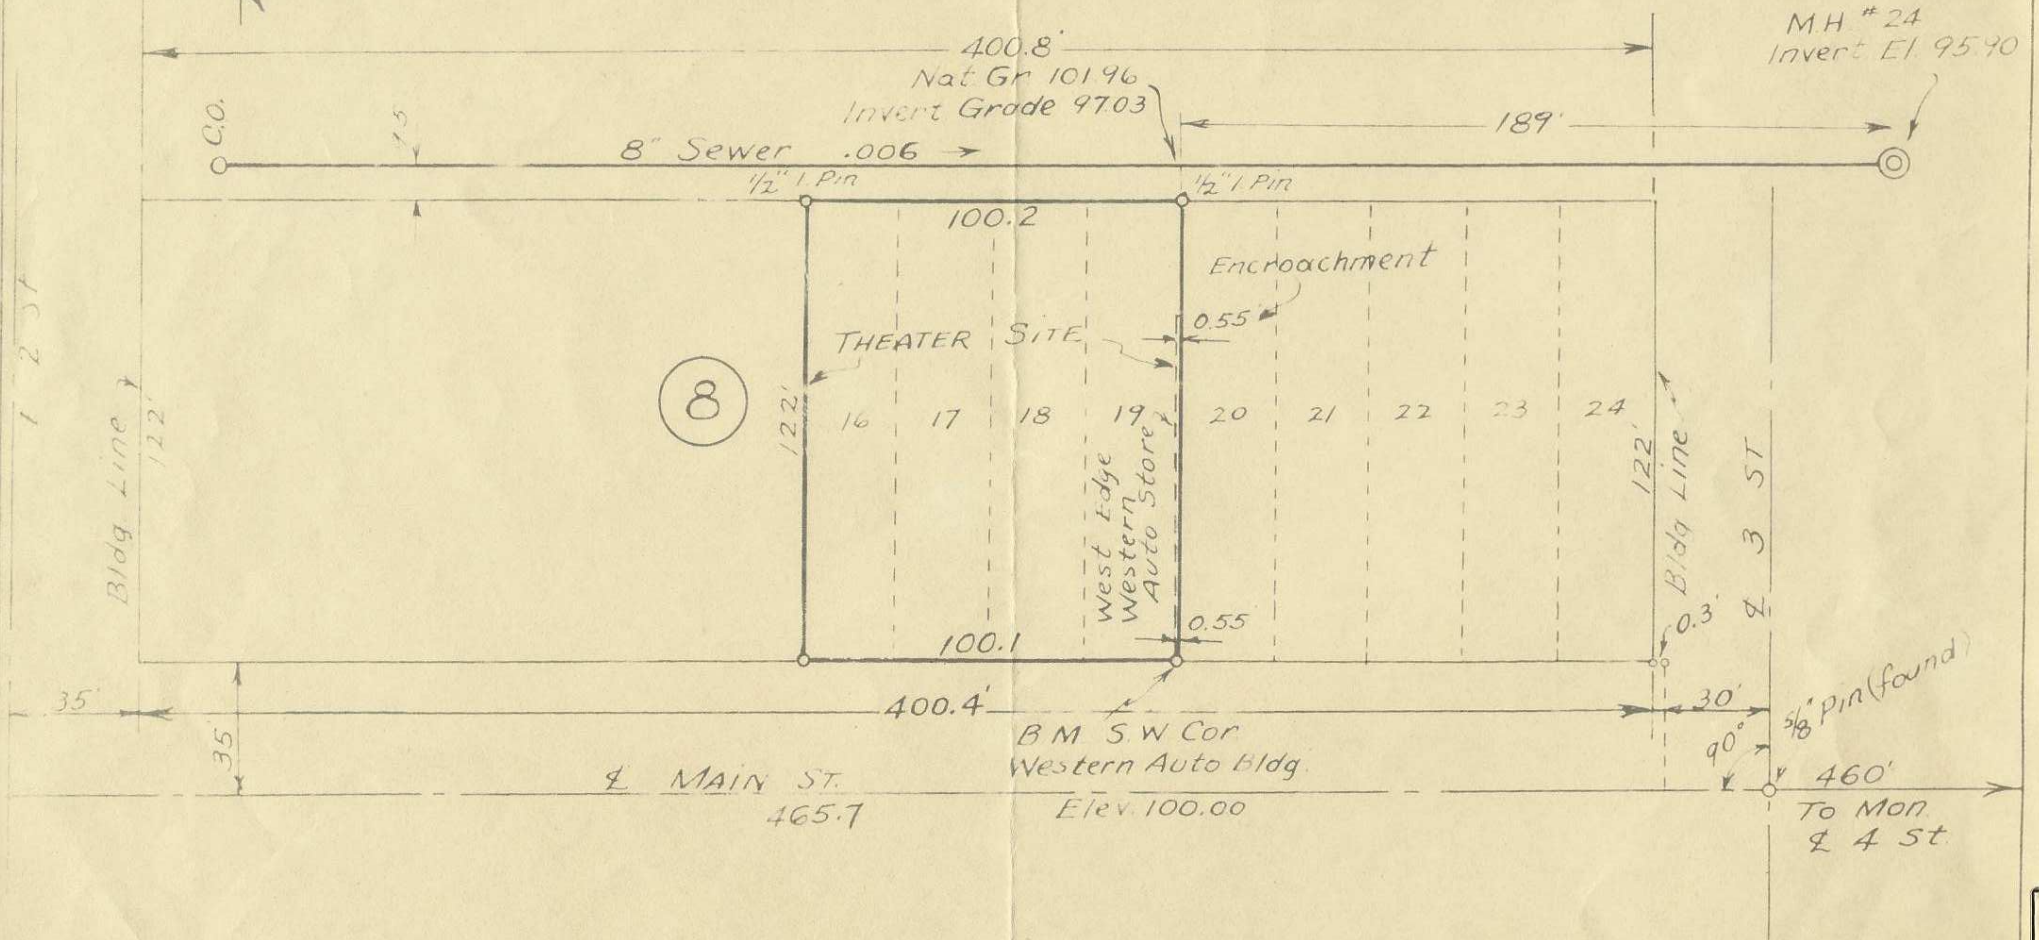

7/2 no repr available