


②-651-Ax

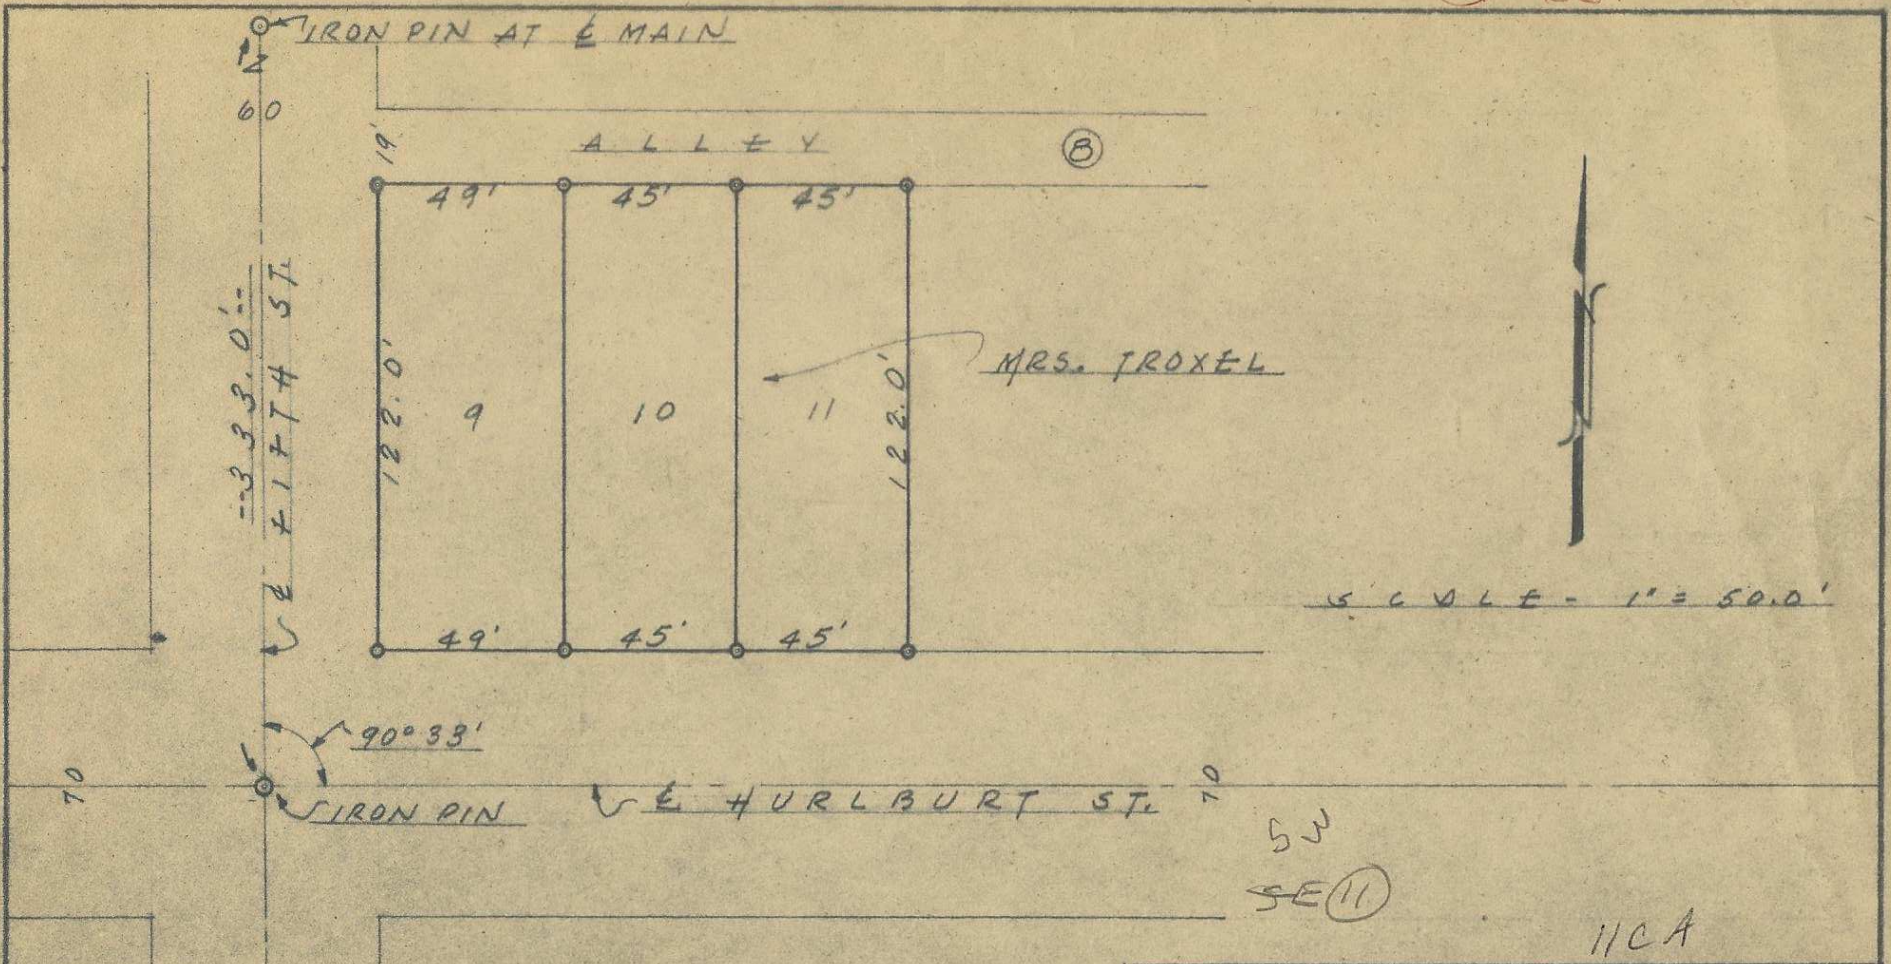

NOTE: IRON PINS AT ALL CORNERS.

C. H. Storms & Associates
CONSULTING ENGINEERS — ARCHITECTS

304 DENNY BUILDING TELEPHONE 4170 WALLA WALLA, WASH.

- Mechanical
- Structural
- Hydraulic
- Sanitary
- Designs
- Land Surveys
- House Plans
- Blue Prints
- Estimates

A SURVEY FOR
 MRS. TROXEL
 LOTS 9-10-11 BLK. B
 NEWPORT ADD'N.
 HERMISTON, ORE.

Date 9/29/48
 Drawn By J.D.B.
 Checked By G.M.N.

670
 SHEET 1 OF

63