
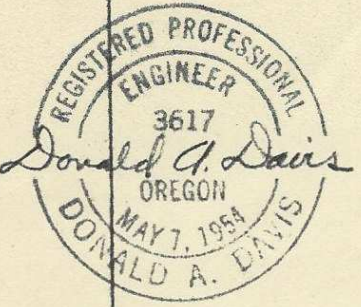


BY D.A.D. DATE 12/29/58 SUBJECT Property Survey For
CHKD. BY DATE Dan Kilmer
Section 12, T.5N. R.35E. W.M.

SHEET NO. 1 OF 1
JOB NO. 58-16
Scale: 1" = 50'-0"

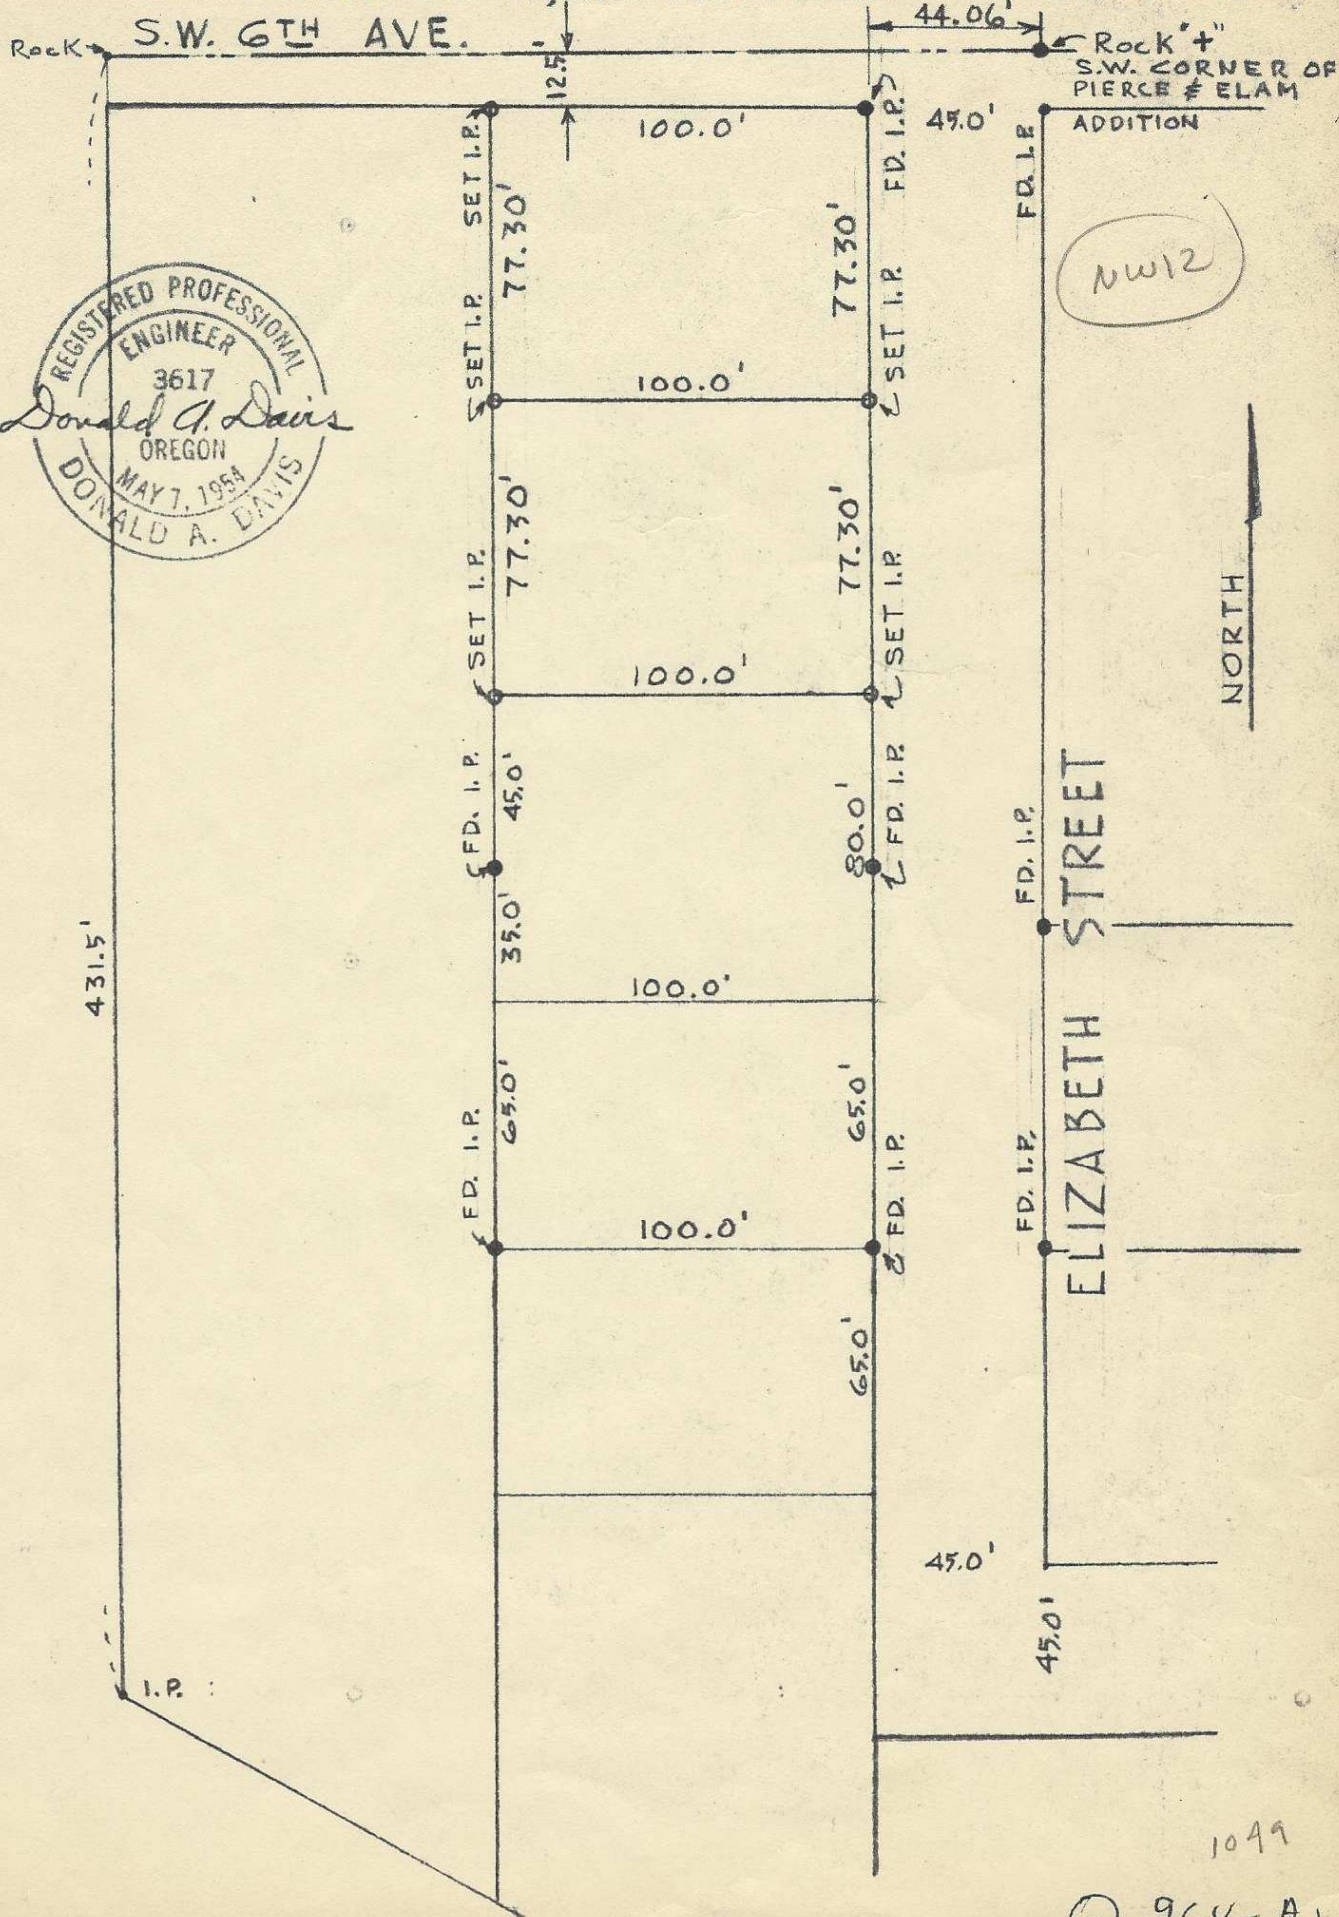

Q-964-Ax

1049
Q-964-Ax