

BY D.A.D. DATE 4/14/58
CHKD. BY DATE


SUBJECT John Yantis Lot
Survey, Sly. 41.0' Lot 7, Nly.
44.0' Lot 6, Block 2, Blacks Add.

SHEET NO. 2 OF 2
JOB NO.

Scale: 1" = 20'

S. ELIZABETH STREET

NORTH

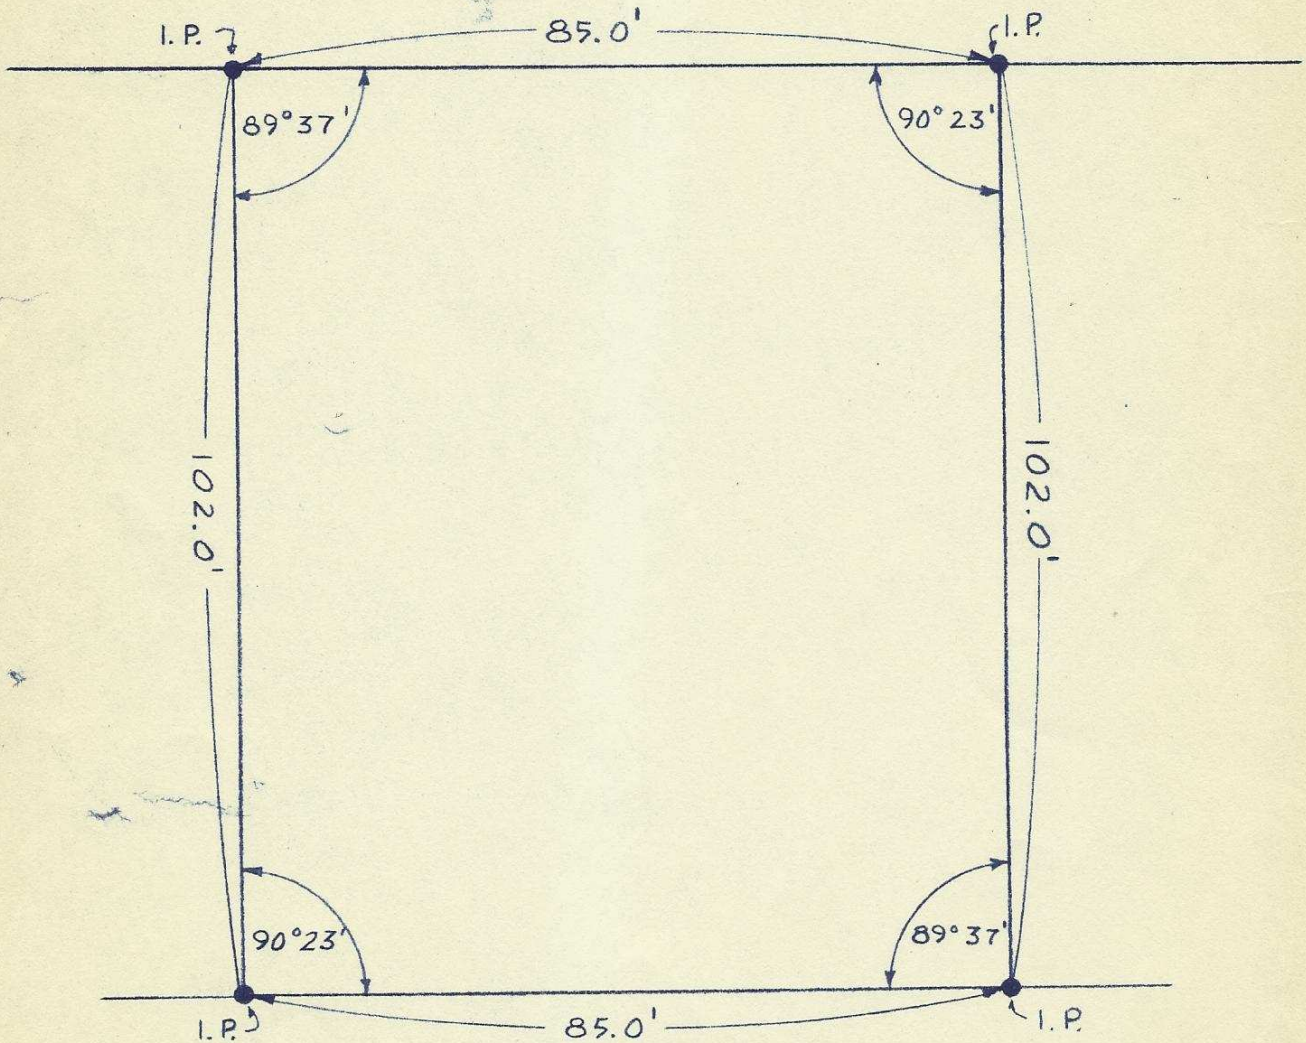

9-983-AX

