


NW (12)

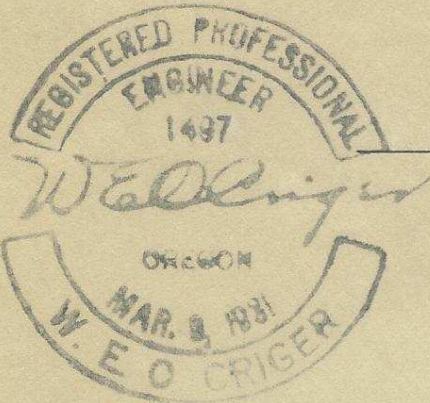

XA-7884-A

Plat Showing Encroachment upon the North side of Maple Street, from the south line of Lot 5 of Block 4 of Columbia Heights Addition, to the town, now City of Milton, Oregon.

Scale: 1 inch = 50 Feet.  
 Surveyed & Platted Oct. 17-1947.  
 By - W. E. O. Criger, Ore. Reg. C. E. No. 1497.

