


②-1019-Ax


OK'S

E O BRIEN

E WOOD ST.

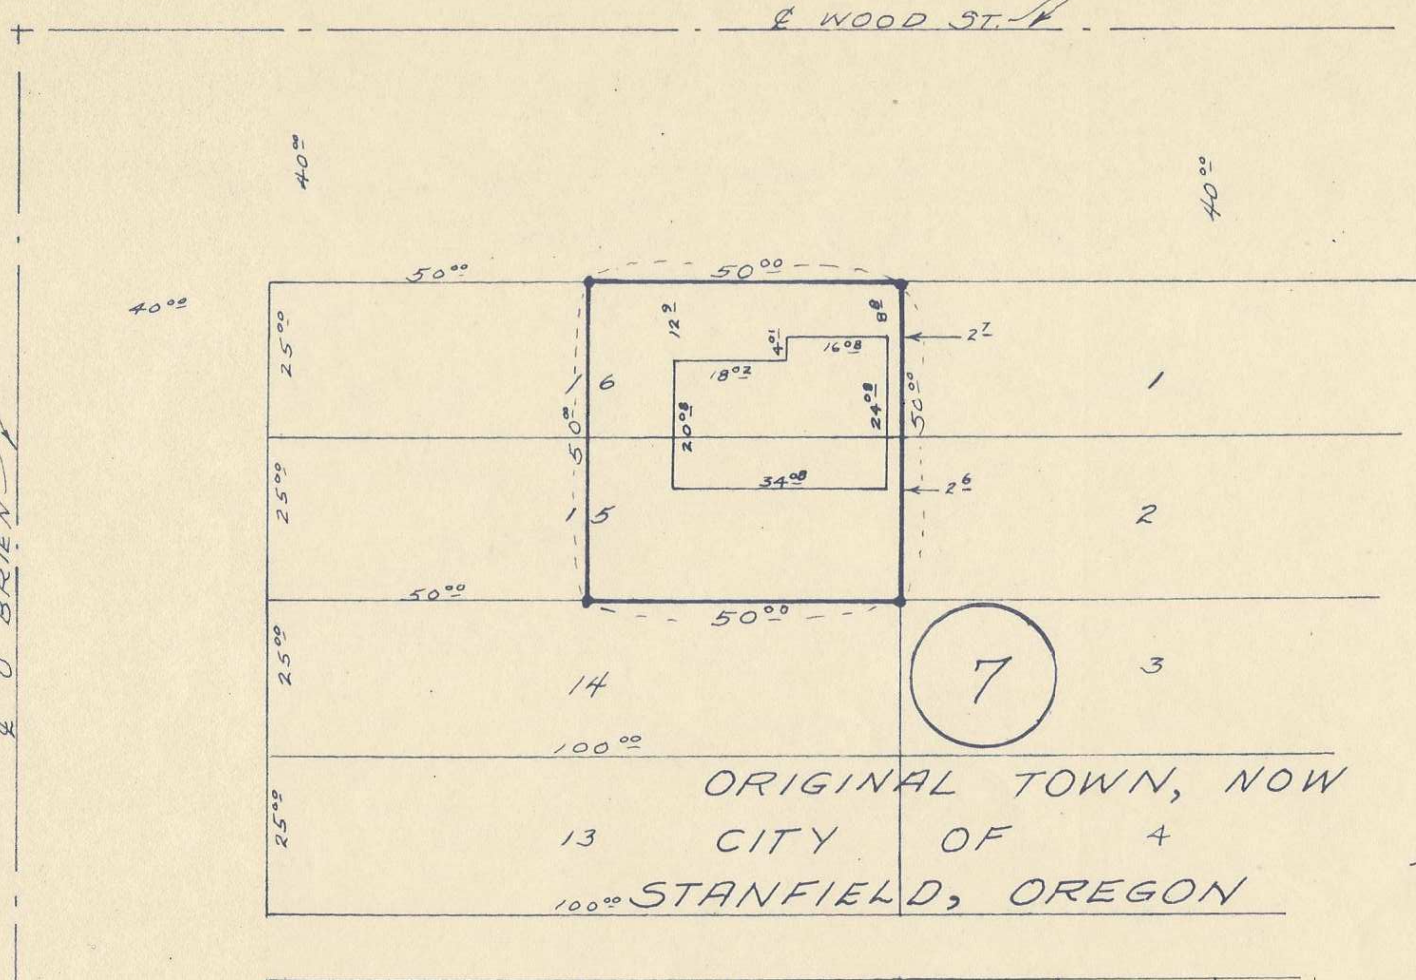

14
100'00"
13 ORIGINAL TOWN, NOW
CITY OF 4
100'00" STANFIELD, OREGON

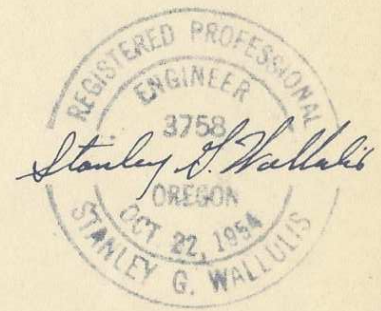

12	11	10	9	8	7	6
----	----	----	---	---	---	---

SURVEY FOR
EAST-WEST REALTY

Scale: 1"=30' Date: 4-25-66 By: S.G.W.

WALLULIS & STAEBLER
Consulting Engineers
P.O. Box 91
Pendleton Oregon

15-D