




Q-1052-25

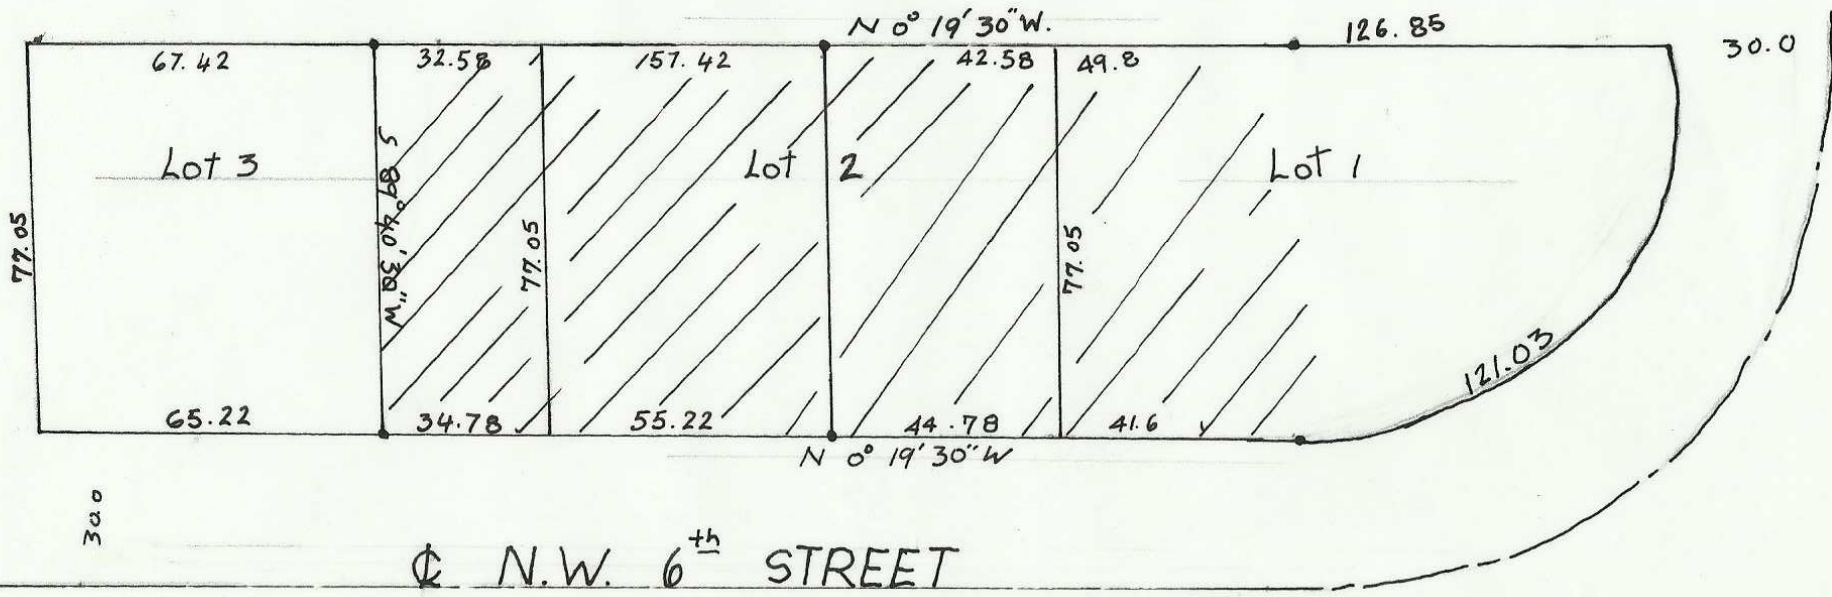

300

N.W. 6<sup>th</sup> STREET

This is a copy traced  
TT Nov, 99

LOT SURVEY for ROBERT STANGIER.	
Scale: 1" = 40'	Feb 6 <sup>th</sup> 1958.
STANLEY G. WALLULIS Consulting Engineer.	
Pendleton	Oregon

Q-1052-Ax.