


Q-1097-AX

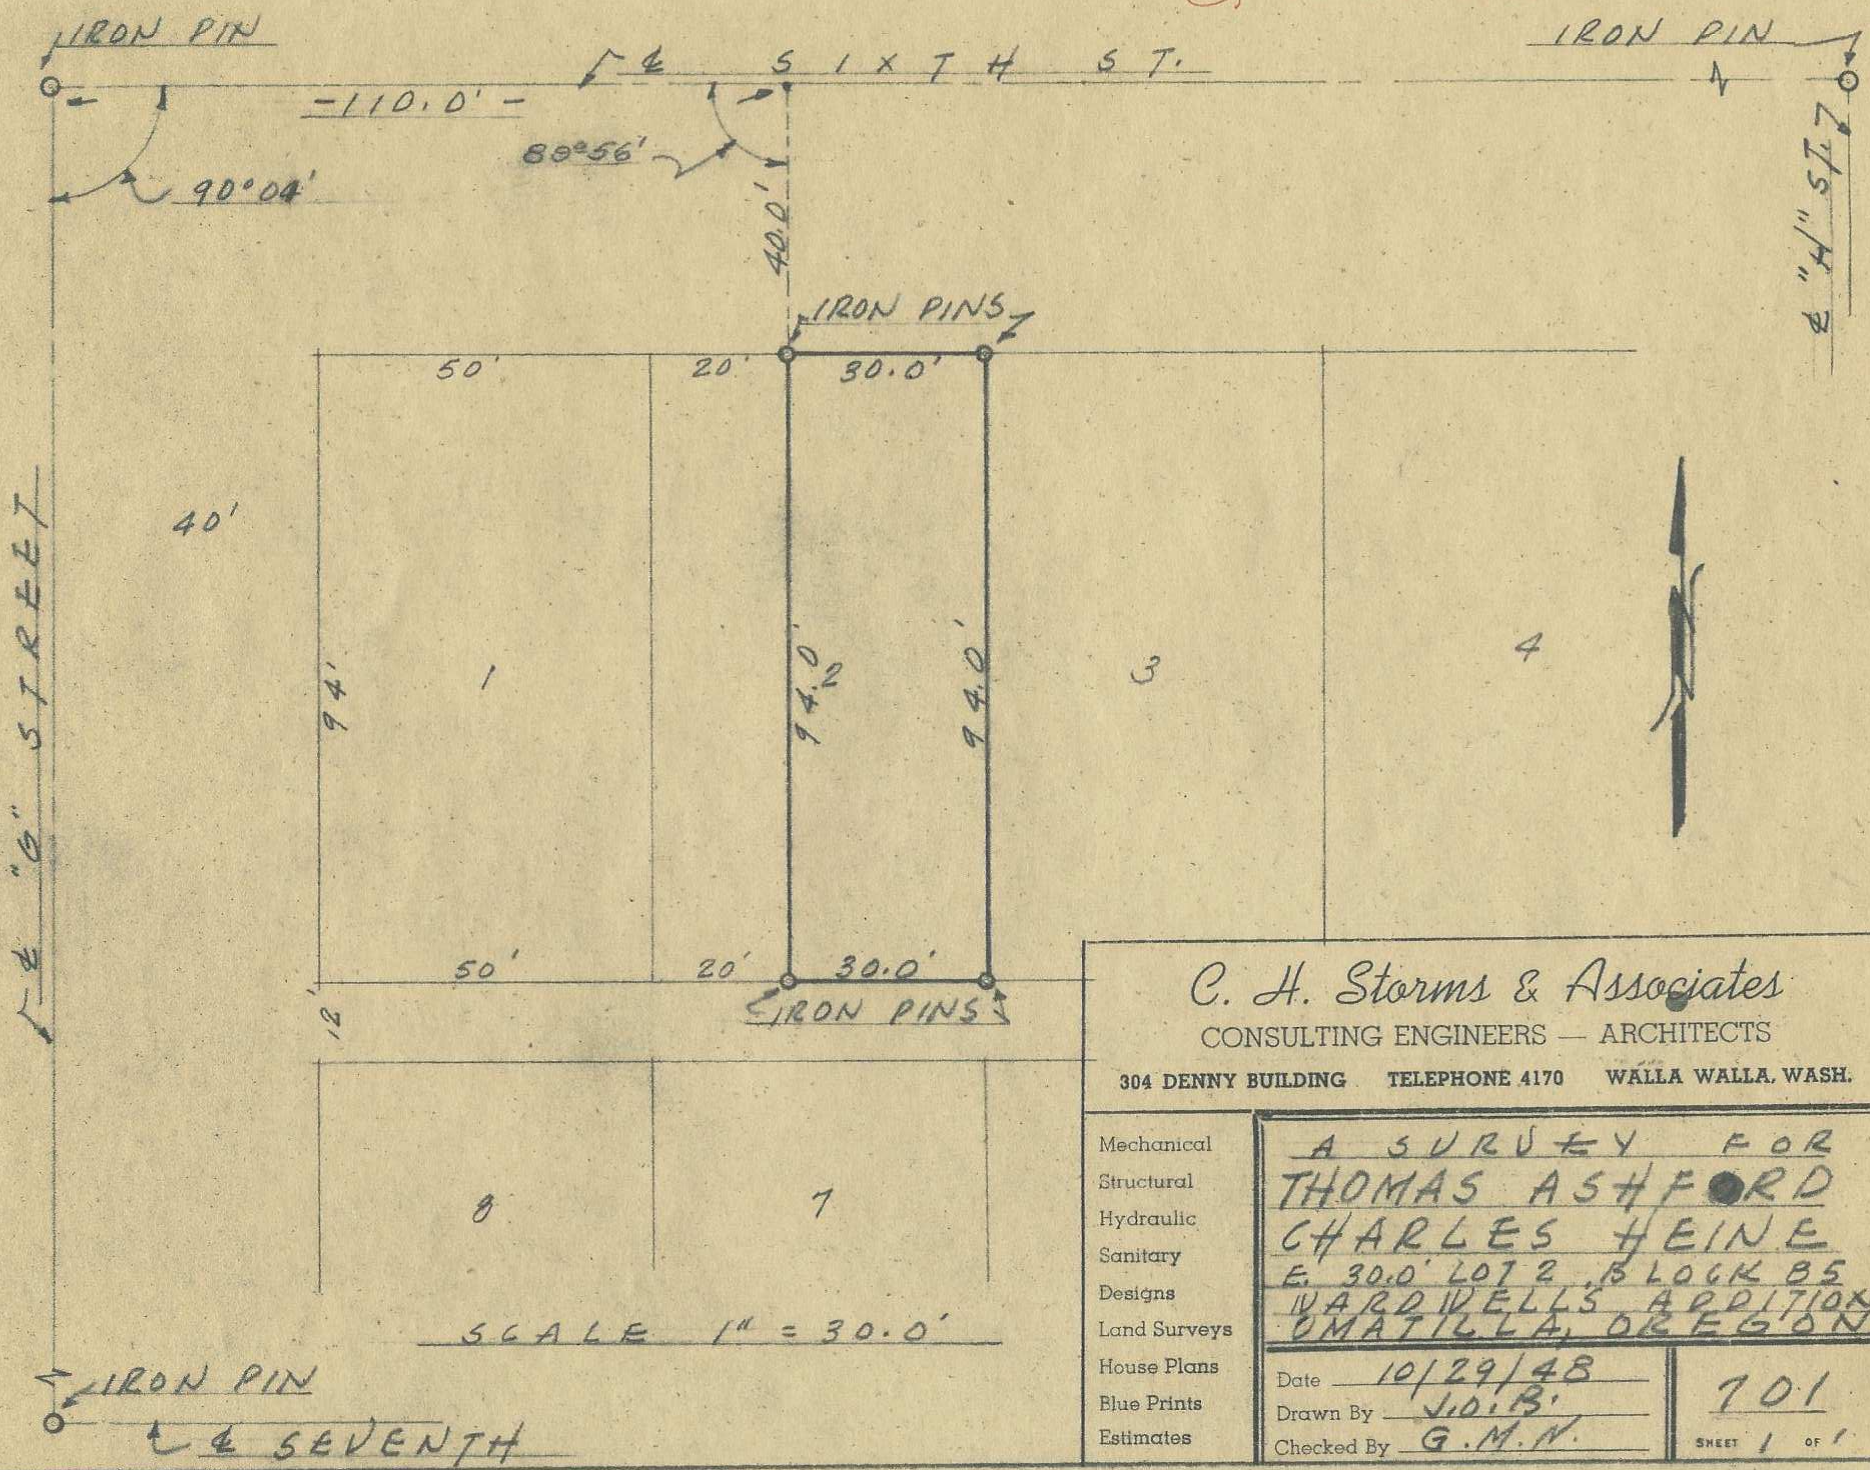

C. H. Storms & Associates  
 CONSULTING ENGINEERS — ARCHITECTS

304 DENNY BUILDING TELEPHONE 4170 WALLA WALLA, WASH.

- Mechanical
- Structural
- Hydraulic
- Sanitary
- Designs
- Land Surveys
- House Plans
- Blue Prints
- Estimates

A SURVEY FOR  
 THOMAS ASHFORD  
 CHARLES HEINE  
 E. 30.0' LOT 2, BLOCK 85  
 WARDWELLS ADDITION  
 MATILLA, OREGON

Date 10/29/48  
 Drawn By J.D.B.  
 Checked By G.M.N.

701  
 SHEET 1 OF 1