


Field Notes

NW¹SE⁴(3)
3DD

By: Tennison & Associates


Date: Nov. 6, 1958 - Cold & Clear

Location: Lot 11, Block 3 of Livermores Second Addition to the City of Pendleton, Oregon

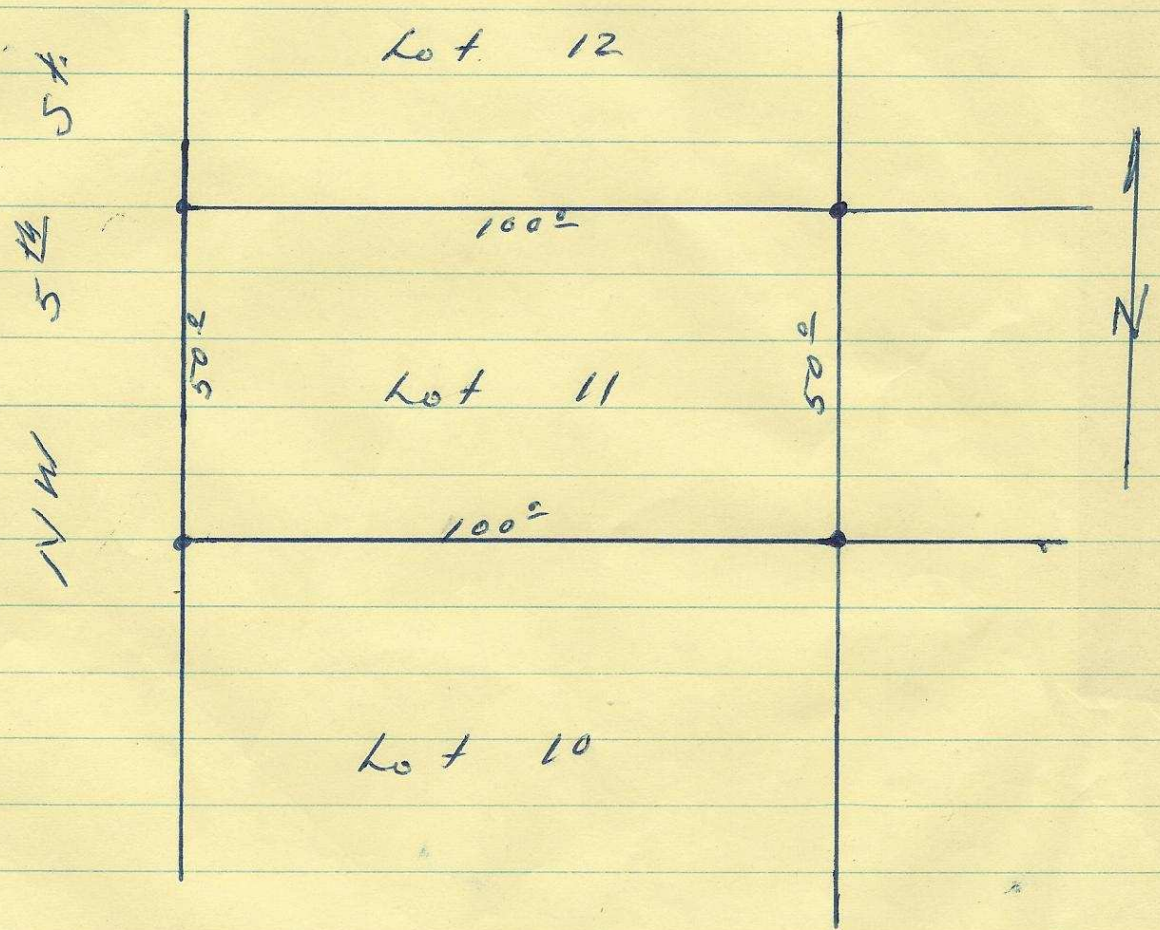

Legend

• - pins set

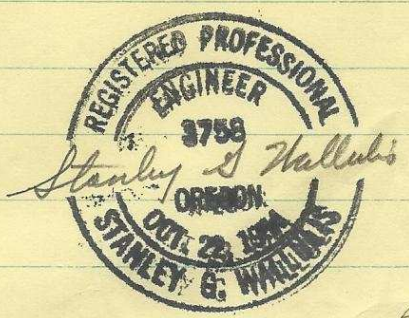

Q-1250-Ax