
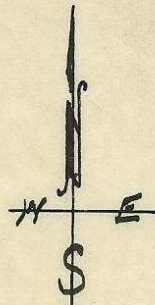


Plat Showing
Block 10 of Reservation Addition,
And Block 6 of Byers Park Addn,
Adjacent Fractional Blocks;
located in Pendleton, Oregon.


Scale: 1 inch = 100 Feet.

Surveys & platted Sept. 25-1947.

By W. E. O. Criger.

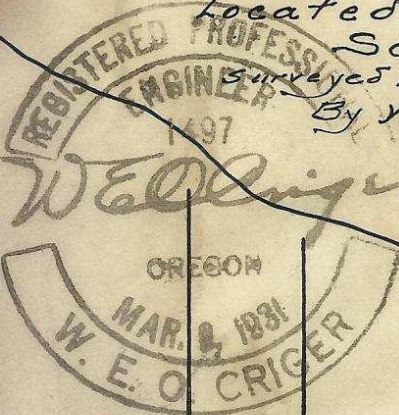

2

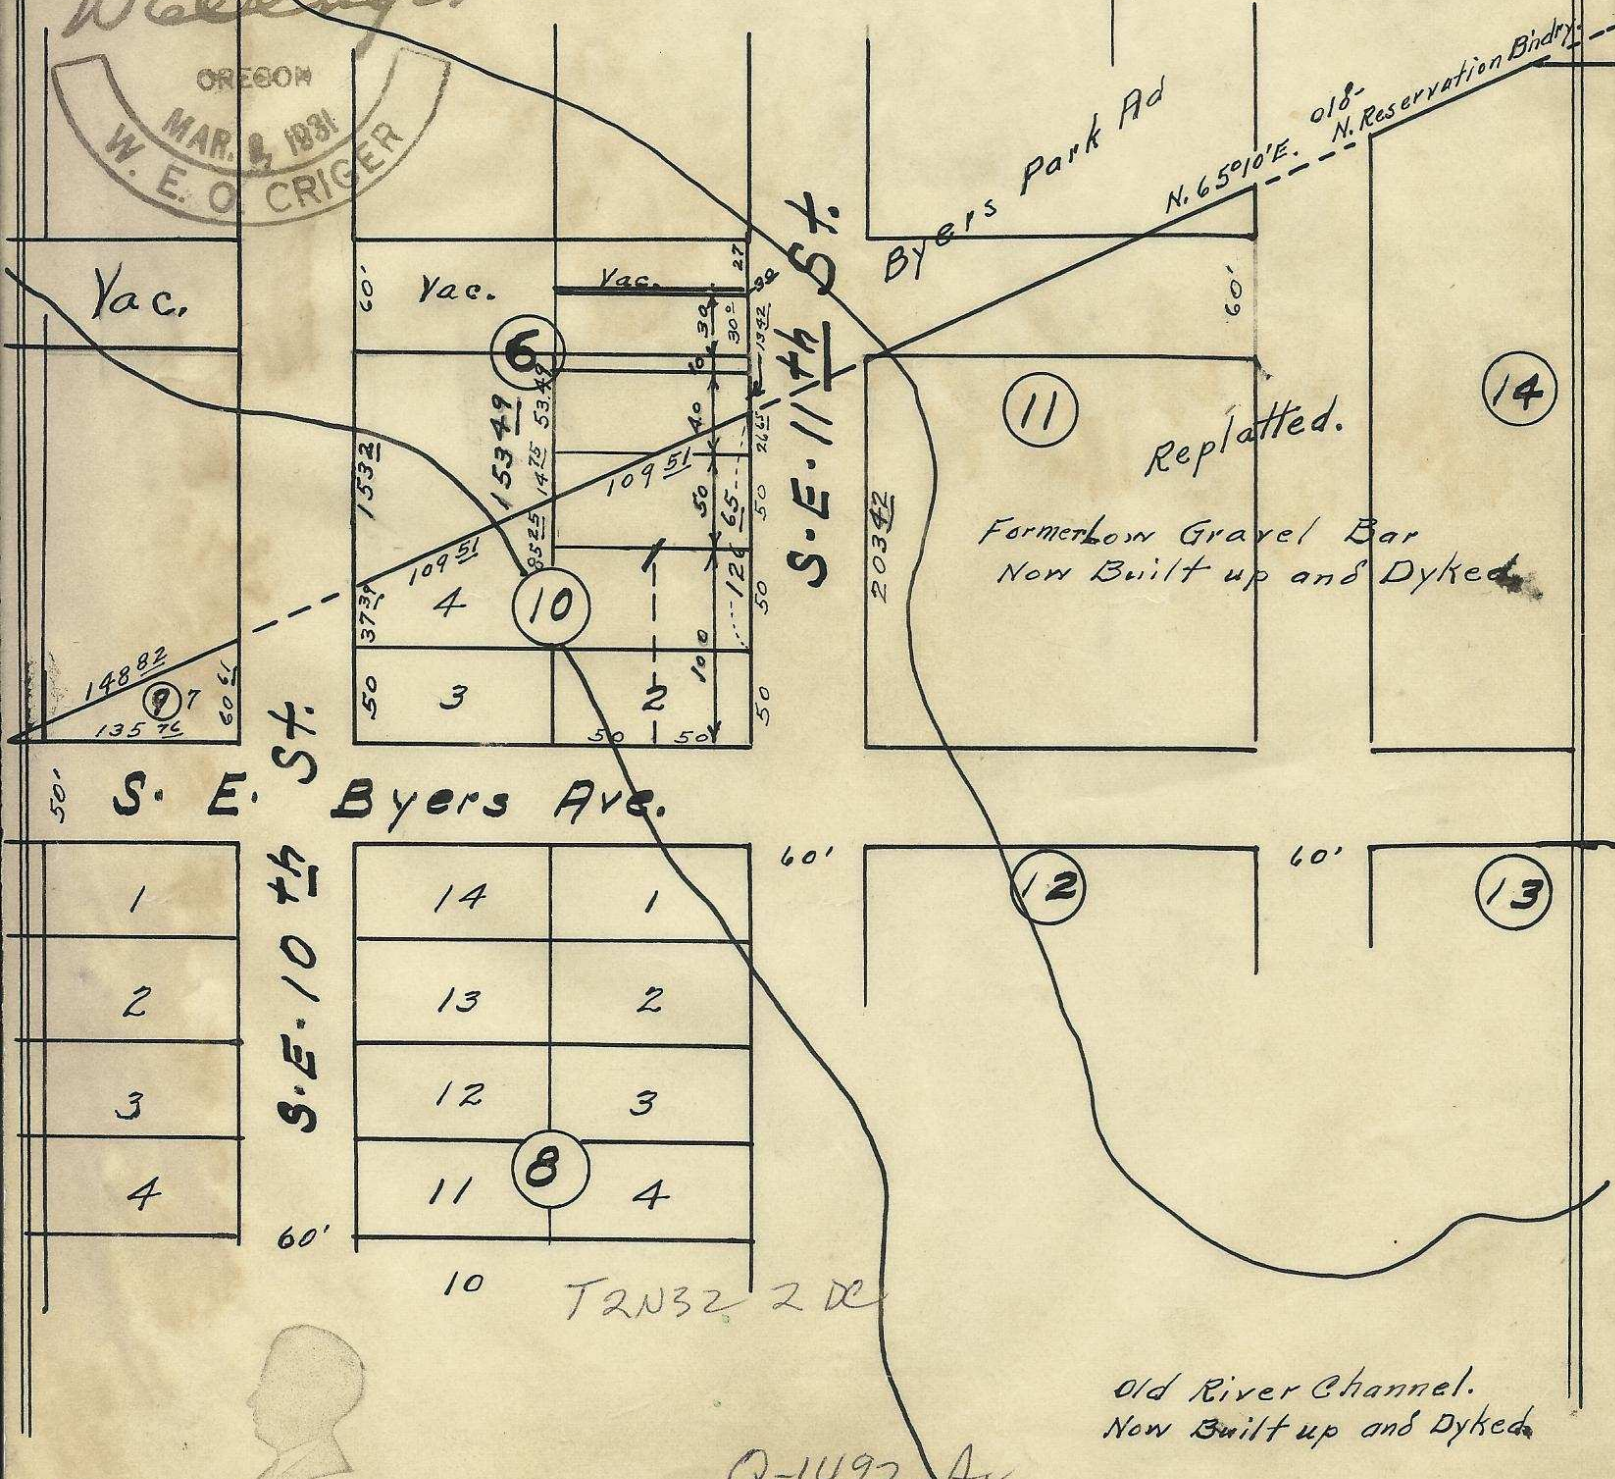

Q-1492-Ax