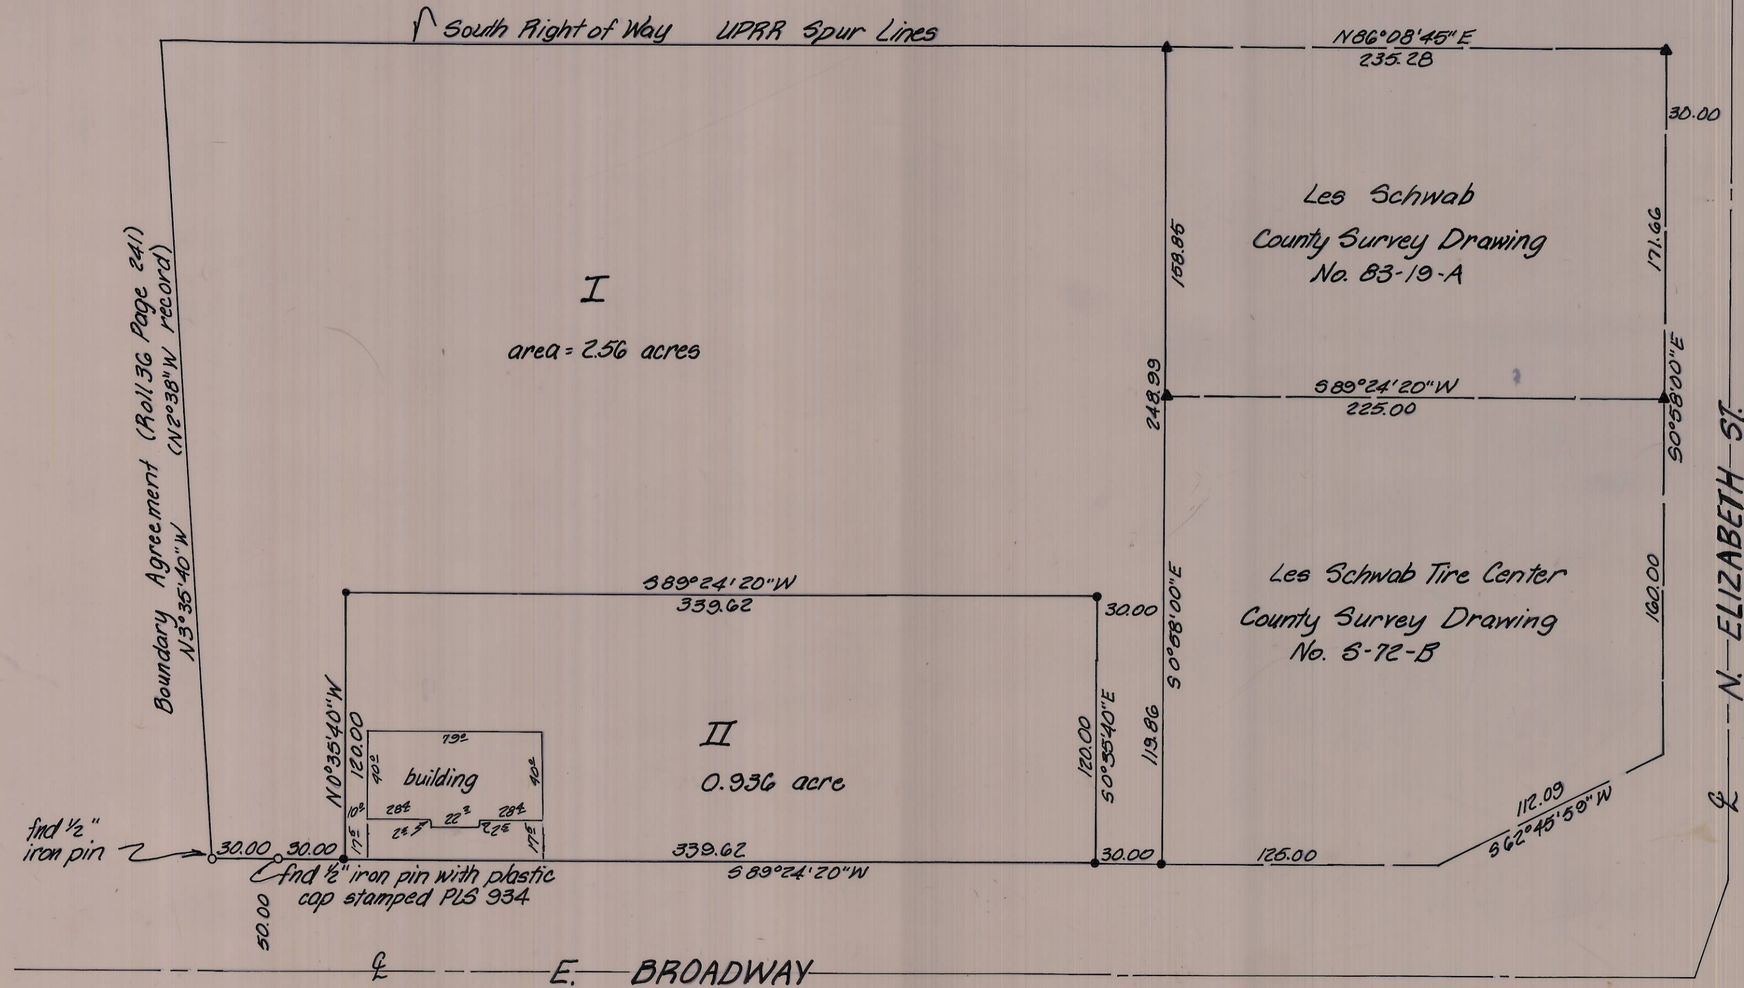

NARRATIVE:

The purpose of this survey was to partition off two parcels from that tract of land belonging to M-F Frozen Foods Inc.; lying North of E. Broadway and West of those parcels previously sold to Les Schwab Tires as shown on County Survey Drawing No. 5-72-B and 83-19-A.

Descriptions were taken from Page 1823 of Roll 58 and Page 241 of Roll 36 of the Deed Records of Umatilla County, Oregon.

All bearings were rotated to match the bearings shown on County Survey Drawing No. 5-72-B.

NOTE:

The building addition on this drawing on 3-11-84 was for the purpose of the plot plan.

- denotes set 5/8" x 30" iron pin with aluminum cap stamped PLS 933
- ▲ denotes found 5/8" x 30" iron pin with aluminum cap stamped PLS 933
- ○ denotes monument found as noted

KRUMBEIN ENGINEERING LTD.
ENGINEERS – SURVEYORS – PLANNERS
361 S.E. Second Pendleton, Oregon

Scale	Drn. By	Drng. No.	Revision 1
1" = 50'	MLD	83-37C	11-15-83
Date 9-19-83	Ckd. By DHK	Job No. 83-96	Revision 2 3-11-84

Survey for

M-F FROZEN FOODS

NW¼, SW¼, Sec. 1, T5N, R35E, W.M.

REGISTERED PROFESSIONAL LAND SURVEYOR
David H Klein
OREGON
DAVID H. KRUMBEIN

RECEIVED BY
Umatilla County Surveyor
Date 4/5/84
Rec'd By bc
No. 84-39-B