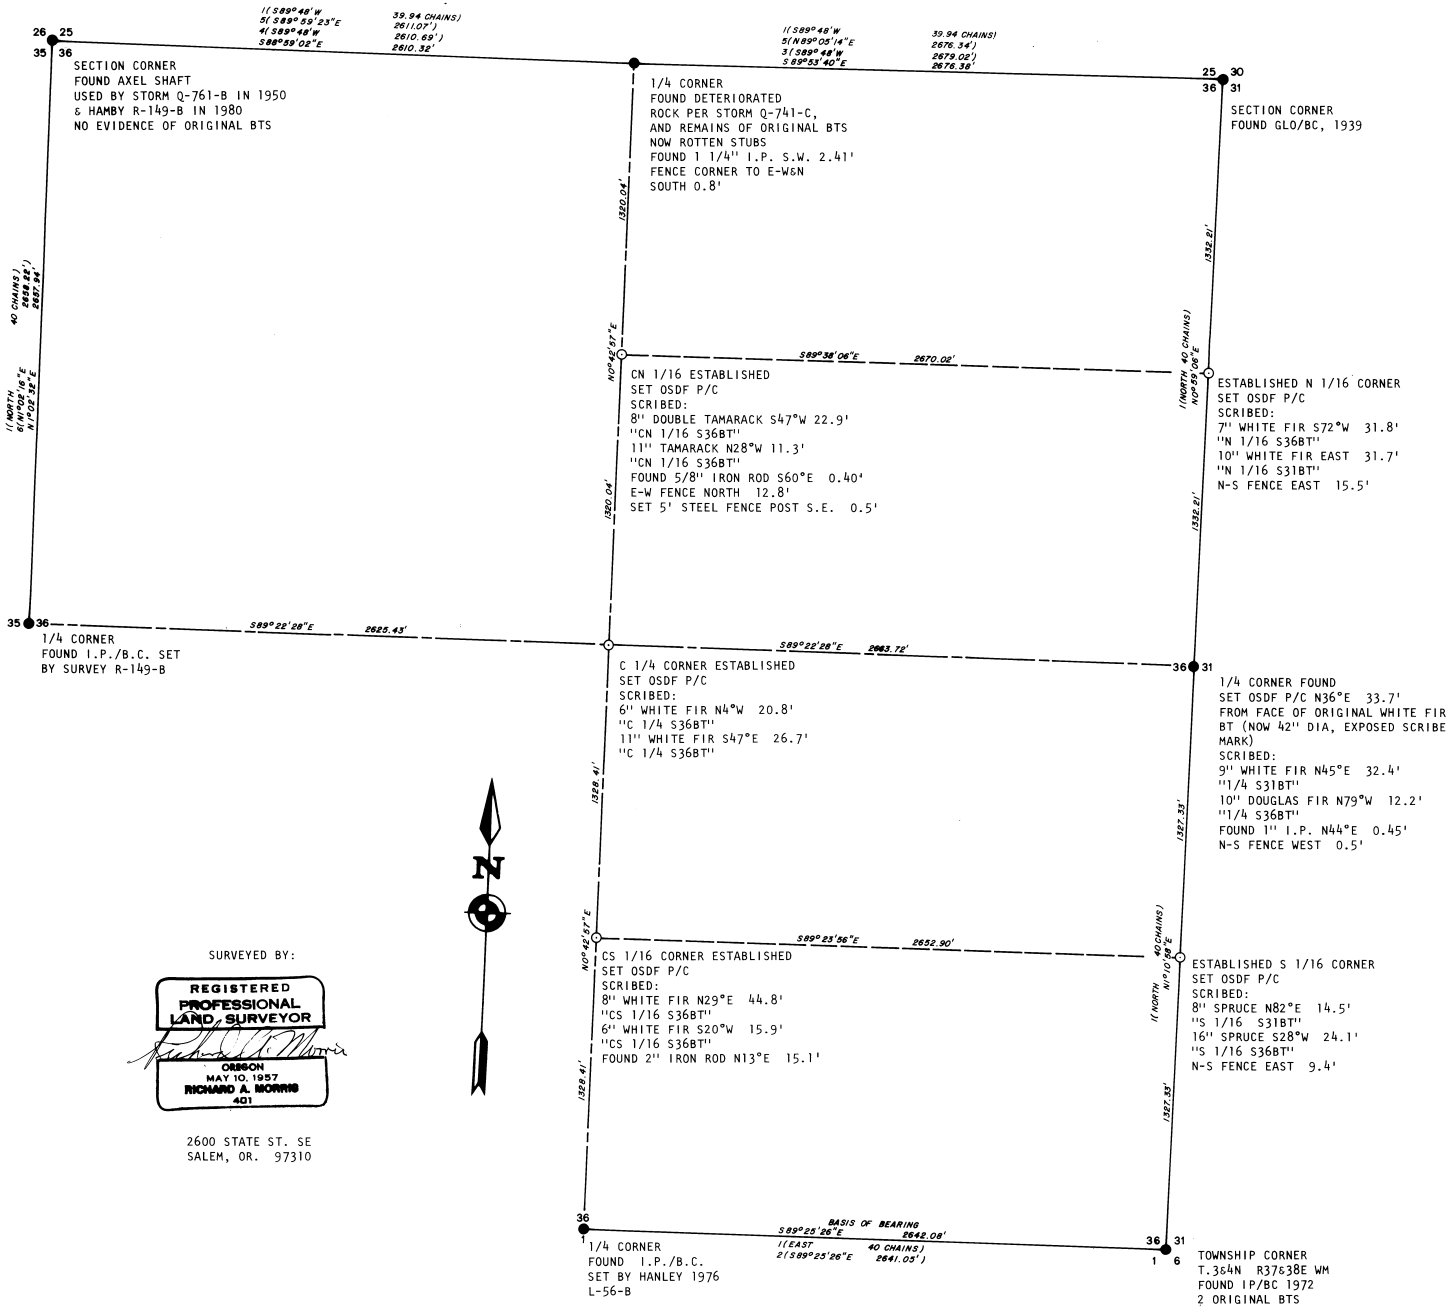

SURVEYED BY:

REGISTERED PROFESSIONAL LAND SURVEYOR
OREGON
MAY 10, 1957
RICHARD A. MORRIS
401

2600 STATE ST. SE
SALEM, OR. 97310

SURVEY PURPOSE

TO ESTABLISH CORNERS AS SHOWN

NARRATIVE

SECTION SUBDIVIDED AND ALL NEW CORNERS MARKED ACCORDING TO "MANUAL OF INSTRUCTIONS FOR THE SURVEY OF THE PUBLIC LANDS OF UNITED STATES 1973". ALL DISTANCES TAKEN TO CENTERS OF NEW BTS. BEARINGS TO BTS WITH MAGNETIC COMPASS 20°E. DECLINATION. PLACED YELLOW, METAL BEARING TREE TAG ON EACH NEW BT.
BEARINGS BASED ON HANLEY L-56-B SURVEY.

LEGEND

●	=FOUND MONUMENT AS NOTED
○	=ESTABLISHED NEW CORNER
OSDF P/C	= OREGON STATE DEPARTMENT OF FORESTRY 1 1/2"X36" ALUMINUM PIPE WITH 3 3/4" CAP WITH MAGNETIC INSERT
GLO/BC	=GENERAL LAND OFFICE BRASS CAP ON IRON PIPE
IP/BC	=IRON PIPE WITH BRASS CAP
BT	=BEARING TREE
1 ( )	=ORIGINAL SURVEY RECORD
2 ( )	=HANLEY, L-56-B, 1976 RECORD
3 ( )	=STORMS, Q-761-B, 1950 RECORD
4 ( )	=MCLIND 83-01-A, 1983 RECORD
5 ( )	=HAMBLETON N-65, 1977 RECORD
6 ( )	=HAMBY R-149-B, 1980 RECORD

SURVEY FOR:
STATE OF OREGON - DEPARTMENT OF FORESTRY

SECTION 36 T.4N., R.37E., W.M.

UMATILLA COUNTY, OREGON
THEODOLITE, E.D.M. & TAPE SURVEY BY:
R. MORRIS, H. BAUGHN, L. HOFFMAN
JULY 12, 1984
SCALE: 1"=400'

RECEIVED BY
Umatilla County Surveyor
Date 9/84
Rec'd By
No. 84-104

B-260

OSDF 7-24-84

B-260