NARRATIVE:

The purpose of this survey was to verify the boundaries of those parcels belonging to Campbell as recorded on Page 631 of Book 317 and Page 597 of Roll 19 of the Deed Records of Umatilla County. Those pins shown as found were set by Wallulis in 1978 and by Wells in 1984 during surveys for E.S. Schnell on the adjoining parcels.

Our survey verified these surveys done previously and an additional point was set as shown. Additional line stakes were set along the lines shown.

Bearings are based upon the 1984 Wells survey, Co Surveyor No 84-1-B

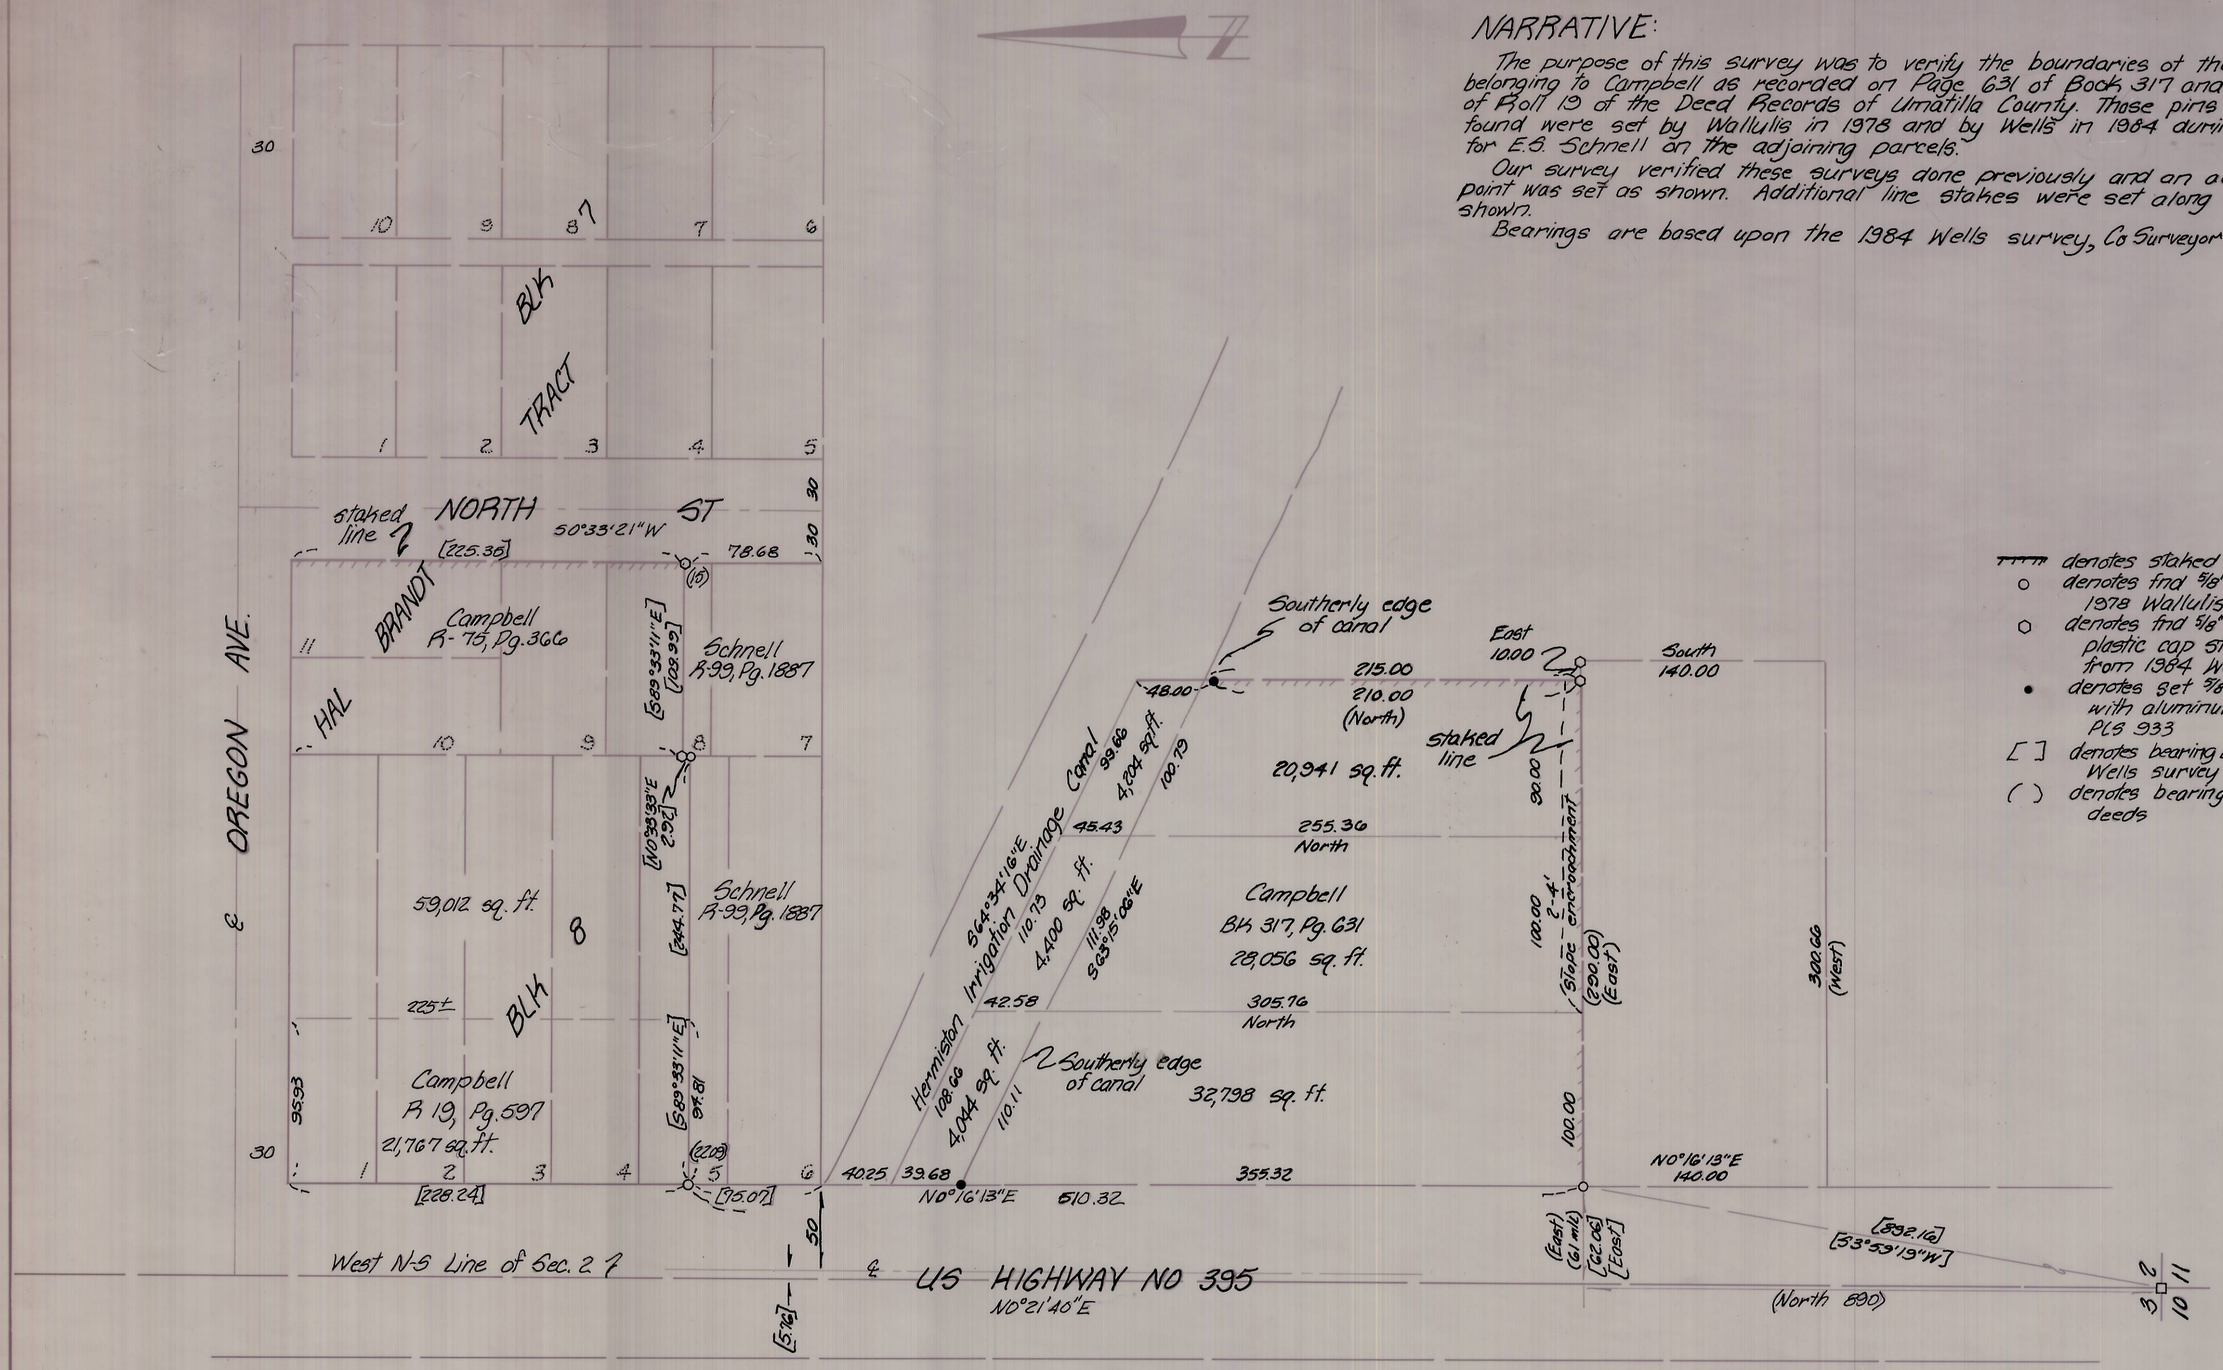

- denotes staked line
- ○ denotes fnd 5/8" iron pin from 1978 Wallulis survey
- ○ denotes fnd 5/8" iron pin with plastic cap stamped PLS 1106 from 1984 Wells survey
- • denotes set 5/8" x 30" iron pin with aluminum cap stamped PLS 933
- [ ] denotes bearing and distance from Wells survey No 84-1-B
- ( ) denotes bearing and distance from deeds

KRUMBEIN ENGINEERING LTD. ENGINEERS – SURVEYORS – PLANNERS 361 S.E. Second Pendleton, Oregon	Scale 1"=60'	Drn. By MLD	Drng. No. 84-66C	Revision 1 1-4-85
	Date 11-28-84	Ckd. By DHK	Job No. 84-128	Revision 2

Survey for

CAMPBELL MOTORS

SW¼, Sec. 2, T4N, R28E, W.M.

REGISTERED PROFESSIONAL LAND SURVEYOR

David H Krumbein

OREGON

DAVID H. KRUMBEIN

933

RECEIVED BY
Umatilla County Surveyor
Date 3/15/85
Rec'd By bc
No. 85-42-B