


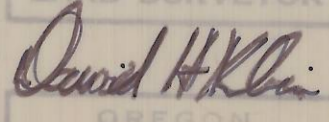
**NARRATIVE:**

The purpose of this survey was to establish the boundaries of that parcel belonging to Mrs. Reeves as shown on a Title Report dated March 18, 1941 supplied by Gene Proden. The description on this title report agrees with the current deed on file in the County Court House.

In 1984 our firm performed a survey, Co. Surveyor No. 84-64-A, that re-established the the East line of Block One of Byers Park Addition. By description this is also the West line of Lot 6 in Section 2, T2N, R32E, W.M.. We used this line to establish the West and East lines of the Reeves property. The North line is established by the bottom of the levee. The South line is the North line of Block 12 of Byers Park Addition.

Bearings and distances are as shown on the original plat. The strip of land on the East side between the fence and the deed line is being described out to give to the neighbor.

- denotes set 5/8" x 30" iron pin with aluminum cap stamped PLB 933
- denotes find 5/8" iron pin, Co. No. 84-64-A.
- denotes find PK nail, Co. No. 84-64-A.
- denotes set PK nail

 <b>KRUMBEIN ENGINEERING LTD.</b> ENGINEERS - SURVEYORS - PLANNERS 361 S.E. Second Pendleton, Oregon	Scale 1"=50'	Drn. By MLD	Drng. No. 85-32C	Revision 1	
	Date 6-19-85	Ckd. By DHL	Job No. 85-81	Revision 2	
Survey for <b>REEVES</b>  Section 2, T2N, R32E, W.M.		REGISTERED PROFESSIONAL LAND SURVEYOR   OREGON JULY 17, 1980 DAVID H. KRUMBEIN 933		RECEIVED BY Umatilla County Surveyor Date 10-14-85 Rec'd By SA No. 85-142-B	