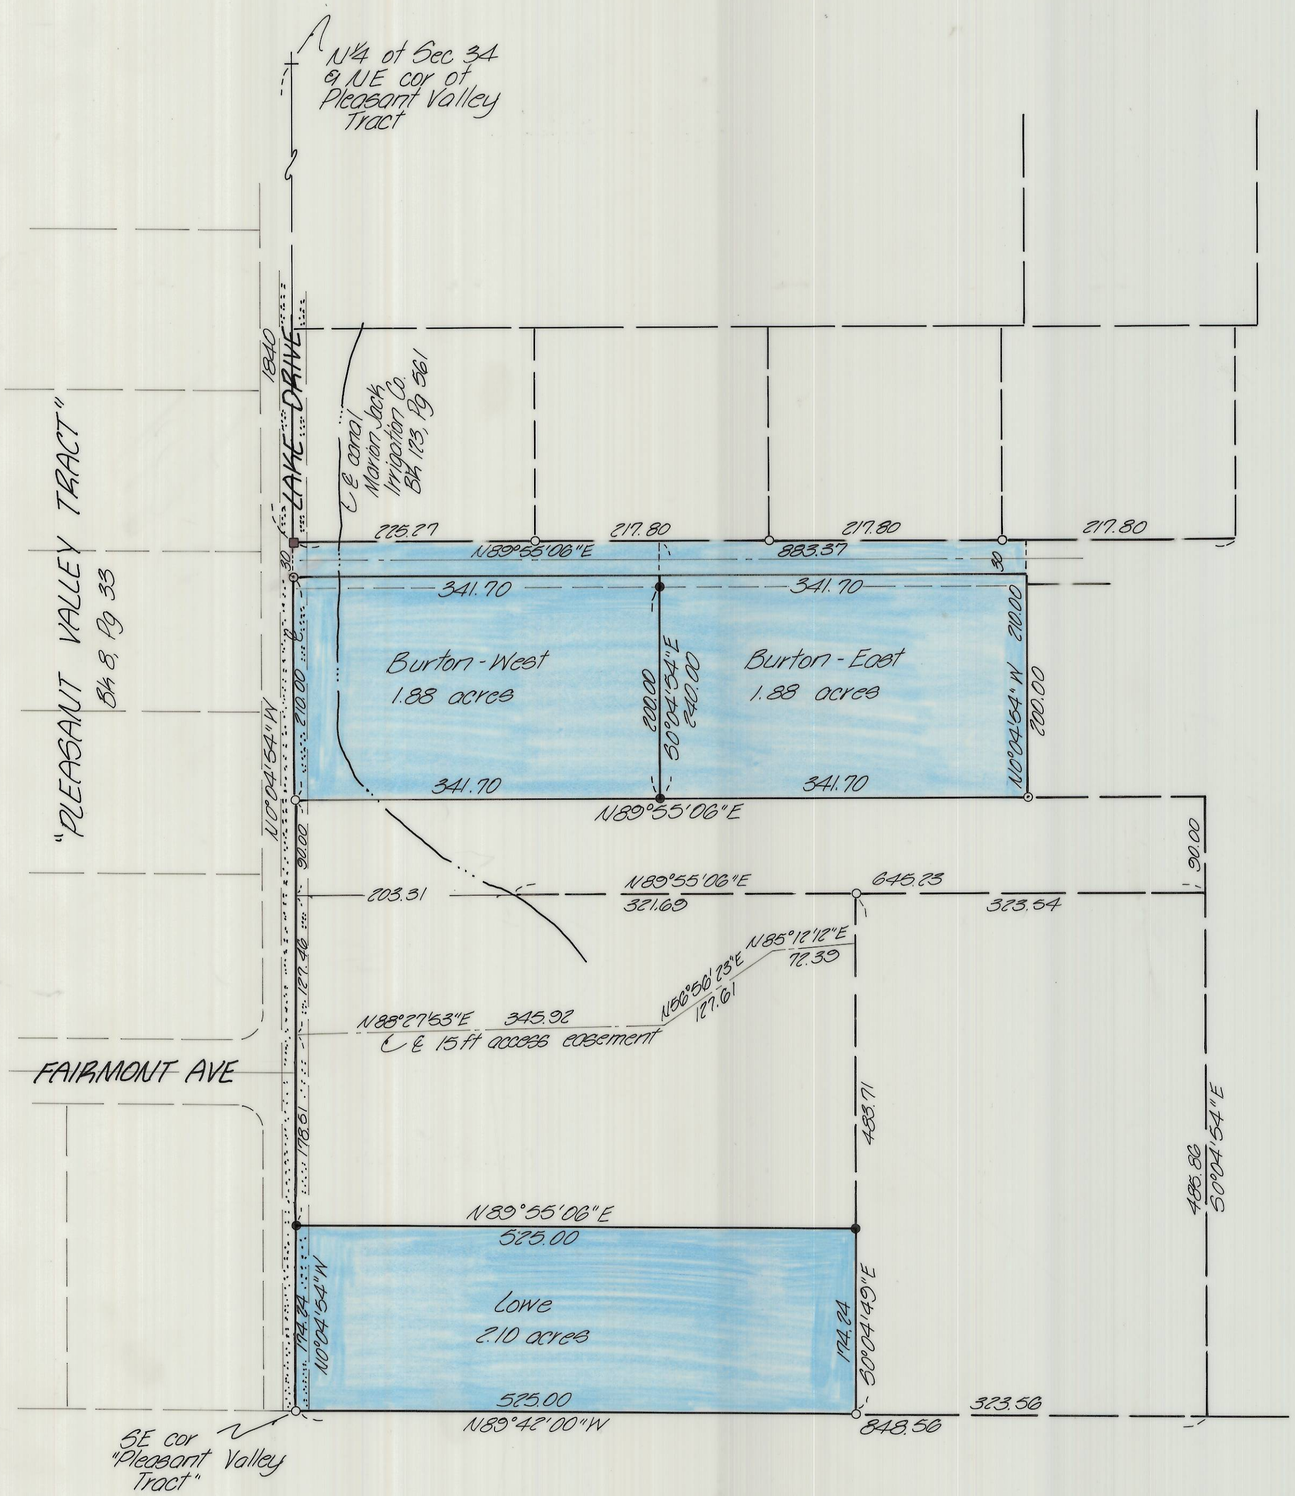

NARRATIVE

The purpose of this survey was to divide into two parcels tracts belonging to Burton and Lowe in the Northeast quarter of Section 34, T7N, R32E, W.M.

Both of the tracts had previously been surveyed by our firm for Burton in 1979, Umatilla County Surveyor's Drawing No. R-100-C and Lowe in 1982, Umatilla County Surveyor's No. 82-47-B.

The survey was based upon those points found as shown. Bearings are based upon the East-West centerline of Section 34 bearing North 0°04'54" West as shown on Umatilla County Surveyors Drawing No. H-751-B.

- ● denotes set 5/8" x 30" iron pin with aluminum cap stamped PLS 933
- ⊙ denotes find 5/8" iron pin, Co Surveyor No R-100-C
- ○ denotes find 5/8" iron pin, Co Surveyor No. 82-47-B
- ■ denotes find P/K spike, Co Surveyor No. R-100-C

KRUMBEIN ENGINEERING LTD.
ENGINEERS – SURVEYORS – PLANNERS
361 S.E. Second Pendleton, Oregon

Scale	Drn. By	Drng. No.	Revision 1
1" = 100'	MLD	86-44C	
Date	Ckd. By	Job No.	Revision 2
10-4-86	DHK	86-74	

Survey for

BURTON - LOWE

NE¼, Sec 34, T7N, R32E, W.M.

REGISTERED PROFESSIONAL LAND SURVEYOR
David H. Krumbein
OREGON
JULY 17, 1970
DAVID H. KRUMBEIN
933

RECEIVED BY
Umatilla County Surveyor
Date 1-87
Rec'd By KA
No. 87-43-B