
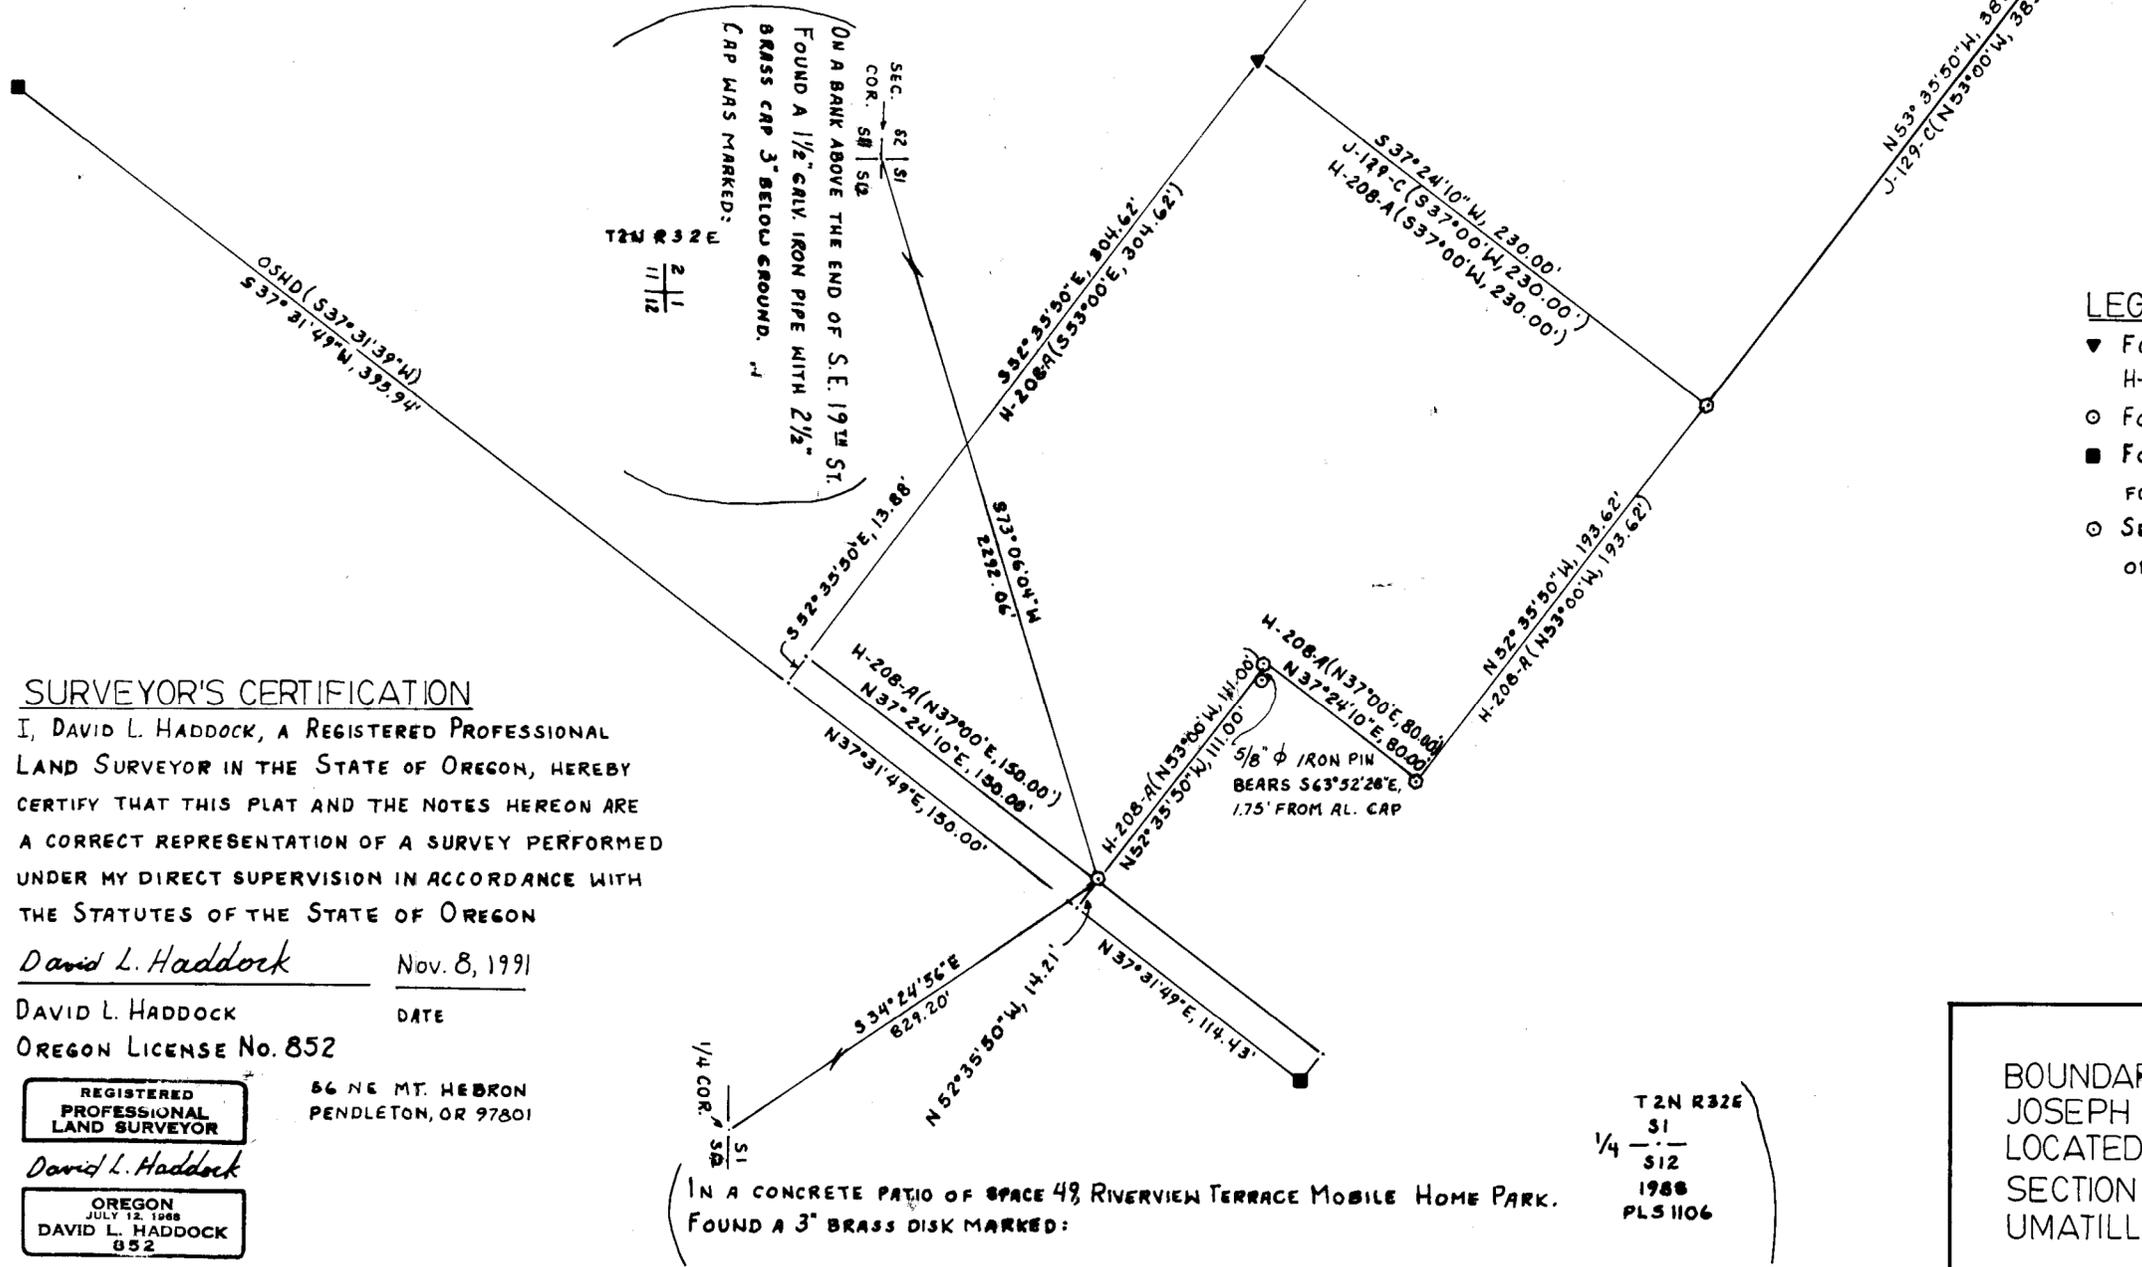


NARRATIVE AND HISTORY

THE PURPOSE OF THIS SURVEY WAS TO RE-ESTABLISH THE BOUNDARIES ALONG THE SOUTHWEST SIDE OF THE JOSEPH LINDELL PROPERTY. THOSE BOUNDARIES HAD BEEN PREVIOUSLY LOCATED AND MONUMENTED BY THE FOLLOWING SURVEYS RECORDED IN THE UMATILLA COUNTY SURVEYOR'S OFFICE:

DATE	SURVEYOR	REG. NO.	RECORD NUMBER
DECEMBER 1972	DAVID KRUMBEIN	PLS 933	H-208-A
MARCH 1974	DAVID KRUMBEIN	PLS 933	I-27-A
APRIL 1975	DONALD STAEBLER	PLS 1333	J-129-C
JUNE 1990	BILL WELLS	PLS 1106	90-50-C

ONLY TWO OF THE MONUMENTS SET ALONG THIS LINE BY THE SURVEYS ABOVE WERE FOUND DUE TO INTERVENING CONSTRUCTION ACTIVITY. MONUMENTS WERE SET IN OCTOBER, 1991. THIS AREA WAS FIRST SURVEYED AS THE LASSEN SUBDIVISION IN MARCH 1920 BY AUBREY PERRY. THOSE LOTS WERE ESSENTIALLY IGNORED BY SUBSEQUENT DEVELOPMENT WITH FIRST AND SECOND STREETS BEING VACATED. ONLY RIVERSIDE AVENUE WAS KEPT. THE SURVEY WAS TIED TO THE SOUTHWEST CORNER AND THE SOUTH ONE-QUARTER CORNER OF SECTION 1 WITH THE BEARINGS BEING BASED ON THE BEARING GIVEN BETWEEN THEM IN SURVEY 90-50-C. THE SURVEY INSTRUMENTS WERE A WILD T2E THEODOLITE AND A WILD DI 1000 DISTANCE METER.

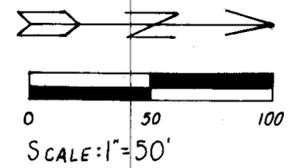

- LEGEND**
- ▼ FOUND RAILROAD SPIKE REFERRED TO BY SURVEY H-208-A.
 - FOUND 5/8" φ IRON PIN SET BY SURVEY J-129-C.
 - FOUND 1/2" φ ALUMINUM CAP SET BY OSHD FOR SHRW.
 - SET 1/2" φ ALUMINUM CAP MARKED PLS 852 ON 1/2" φ BY 24" REBAR.

SURVEYOR'S CERTIFICATION
 I, DAVID L. HADDOCK, A REGISTERED PROFESSIONAL LAND SURVEYOR IN THE STATE OF OREGON, HEREBY CERTIFY THAT THIS PLAT AND THE NOTES HEREON ARE A CORRECT REPRESENTATION OF A SURVEY PERFORMED UNDER MY DIRECT SUPERVISION IN ACCORDANCE WITH THE STATUTES OF THE STATE OF OREGON

David L. Haddock Nov. 8, 1991
 DAVID L. HADDOCK DATE
 OREGON LICENSE NO. 852

REGISTERED PROFESSIONAL LAND SURVEYOR
David L. Haddock
 OREGON JULY 12, 1988
 DAVID L. HADDOCK 852

56 NE MT. HEDRON
 PENDLETON, OR 97801

RECEIVED BY
 Umatilla County Surveyor
 Date *12-91*
 Rec'd by *JK*
 No. *91-90-B*

BOUNDARY SURVEY FOR PROPERTY OF JOSEPH LINDELL
 LOCATED IN THE SE 1/4 OF THE SW 1/4, SECTION 1, T.2N., R.32E., W.M. UMATILLA COUNTY, OREGON

IN A CONCRETE PATIO OF SPACE 49, RIVERVIEW TERRACE MOBILE HOME PARK.
 FOUND A 3" BRASS DISK MARKED:
 T2N R32E
 S1
 1/4
 S12
 1988
 PLS 1106