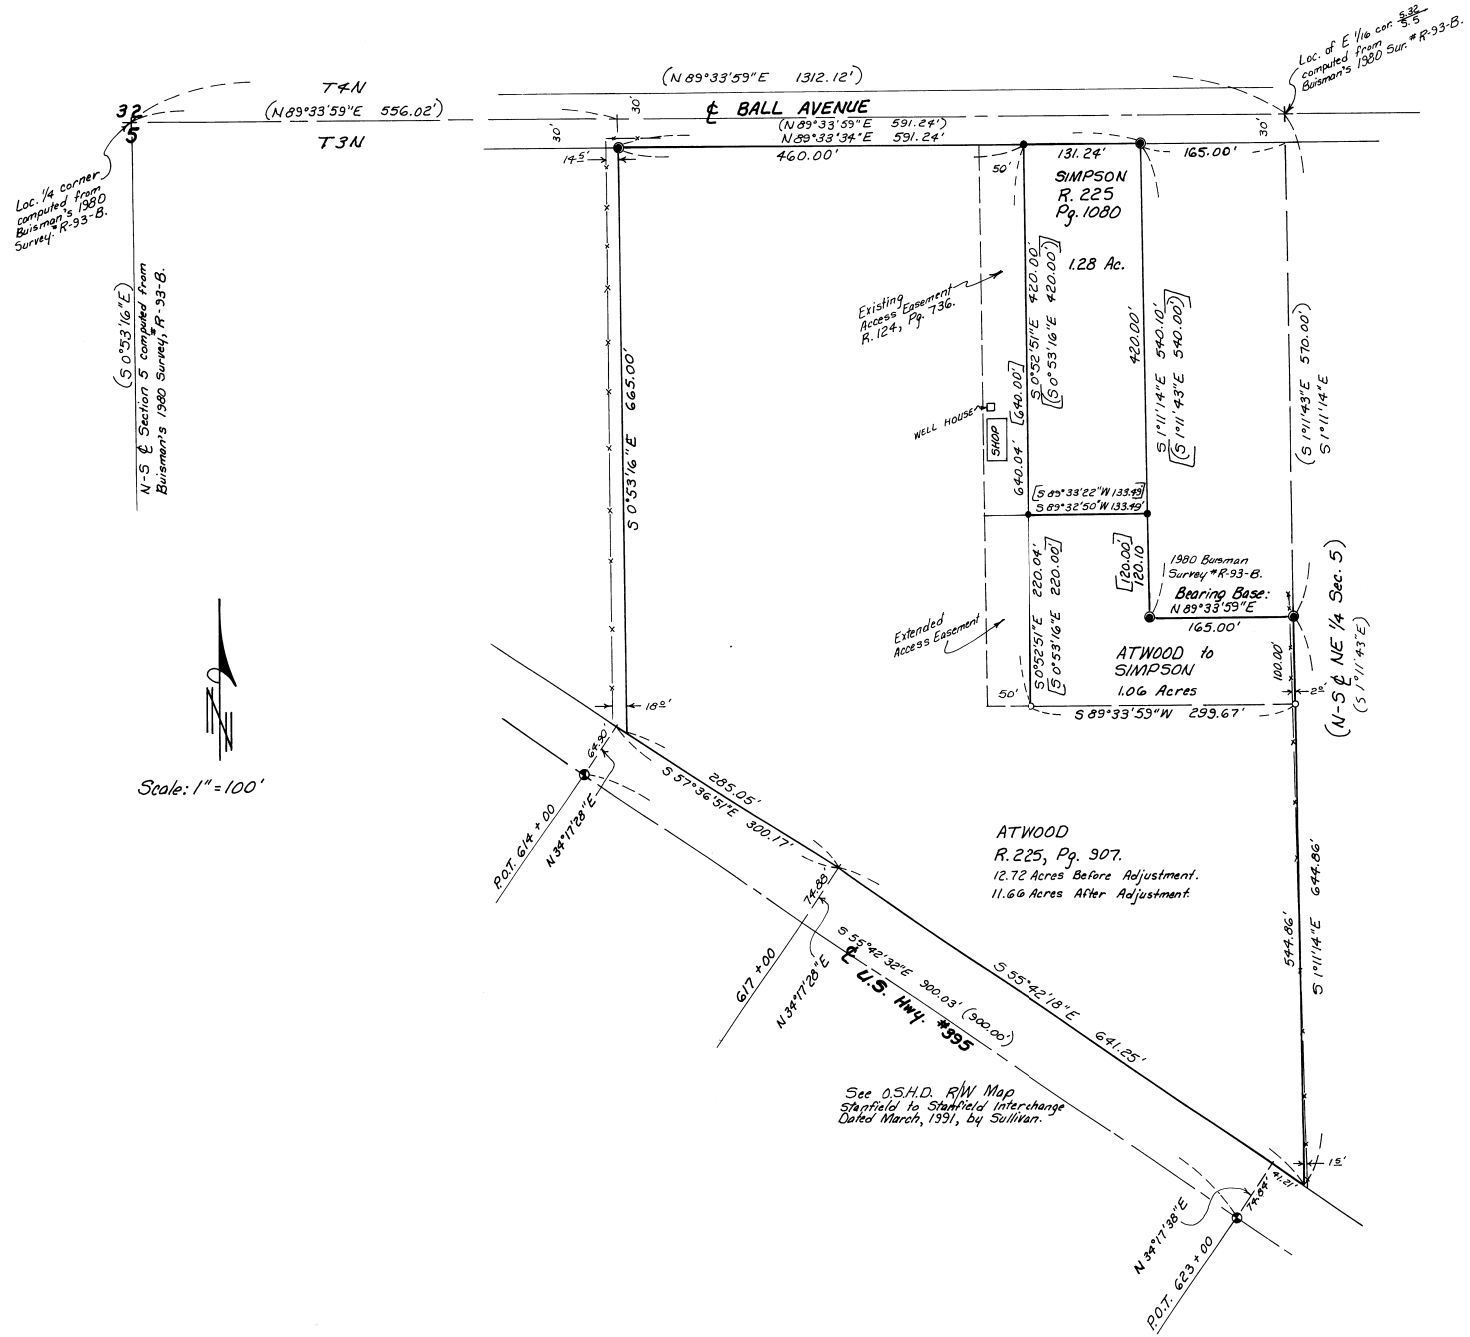

NARRATIVE:

The purpose of this survey is to do a boundary line adjustment. 1.06 acres is taken from Atwood's parcel, R. 225, Page 907, and added to Simpson's parcel, R. 225, Page 1080.

Jim Buisman surveyed Atwood's parcel in a 1980 survey for Hughes (Co. # R-93-B) and I surveyed Simpson's parcel in May, 1992 for H.U.D. I based the bearings and the Section subdivision on Buisman's survey. The South two corners of Buisman's survey were obliterated by Highway construction in 1991.

LEGEND:

- Found 3" Brass Cap in monument box. O.S.H.D. March, 1991, Sullivan.
- Found 5/8" rebar. Buisman, 1980 Survey for Hughes, R-93-B.
- Found 1/2" rebar with plastic cap #951. Me, 1992 Survey for H.U.D.
- Set 1/2" x 24" rebar with plastic cap #951.
- (ooo) of Record. Buisman's 1980 Sur. R-93-B.
- [ooo] of Record. Deeds.

REGISTERED PROFESSIONAL LAND SURVEYOR
G. Dennis Edwards
OREGON
JULY 1971
G. DENNIS EDWARDS
951

RECEIVED BY
Umatilla County Surveyor
Date 4-6-93
93-38-B

Survey for **MALVIN ATWOOD**
In NE 1/4 Section 5, T3N, R29E, W.M.
Umatilla County, Oregon
11/23/92 Job #89210075
Edwards Surveying P.O. Box 763
567-3336 Hermiston, Oregon 97838