


RECORD OF SURVEY PLAT

DALE 1993 CADASTRAL SURVEY
CONTRACT NO. 53-04R3-3-14

PERFORMED FOR THE USDA-FOREST SERVICE,
UMATILLA NATIONAL FOREST
SECTIONS 2, 10, 11, 12, T7S., R31E., W.M.
GRANT COUNTY, OREGON.

LEGEND

- - FOUND EXISTING CORNER MONUMENT AS NOTED.
- - FOUND ACCEPTABLE ORIGINAL CORNER EVIDENCE AND RE-MONUMENTED WITH 2 1/2" X 30" ALUM. PIPE WITH 2 1/2" ALUM. CAP. SEE CORNER RECORD FILED SEPARATELY.
- - FOUND 2 1/2" BRASS CAP ON 2 1/2" GALV. IRON PIPE SET BY LARRY D. BISHOP, LS 846, AS INDICATED ON MAP OF SURVEY NO. 654 OR 655.
- - CORNER ESTABLISHED BY SURVEY. MONUMENTED WITH A 2 1/2" X 30" ALUM. PIPE WITH 2 1/2" ALUM. CAP. SEE CORNER RECORD FILED SEPARATELY.
- - NATIONAL FOREST BOUNDARY POSTED ON THIS SURVEY WITH 6" STEEL OR WOOD FENCE POSTS WITH SIGNS 54-2 ATTACHED.
- (XOX)R1 - RECORD REPORTED ON CONTRACT NO. 380 BY FRANK W. CAMPBELL, U.S. DEPUTY SURVEYOR, UNDER CONTRACT DATED MARCH 19, 1881.
- (XOX)R2 - RECORD REPORTED ON CONTRACT NO. 380 BY HENRY MELDRUM, U.S. DEPUTY SURVEYOR, UNDER CONTRACT DATED MARCH 19, 1881.
- (XOX)R3 - RECORD REPORTED BY LARRY D. BISHOP, LS 846, ON MAP OF SURVEY NO. 654 OR 655.
- - ROADS.
- - FENCES.
- O.H.P. - OVERHEAD POWER LINE.
- M - INDICATES EXISTING CORNER MONUMENT MAINTAINED ON THIS SURVEY.

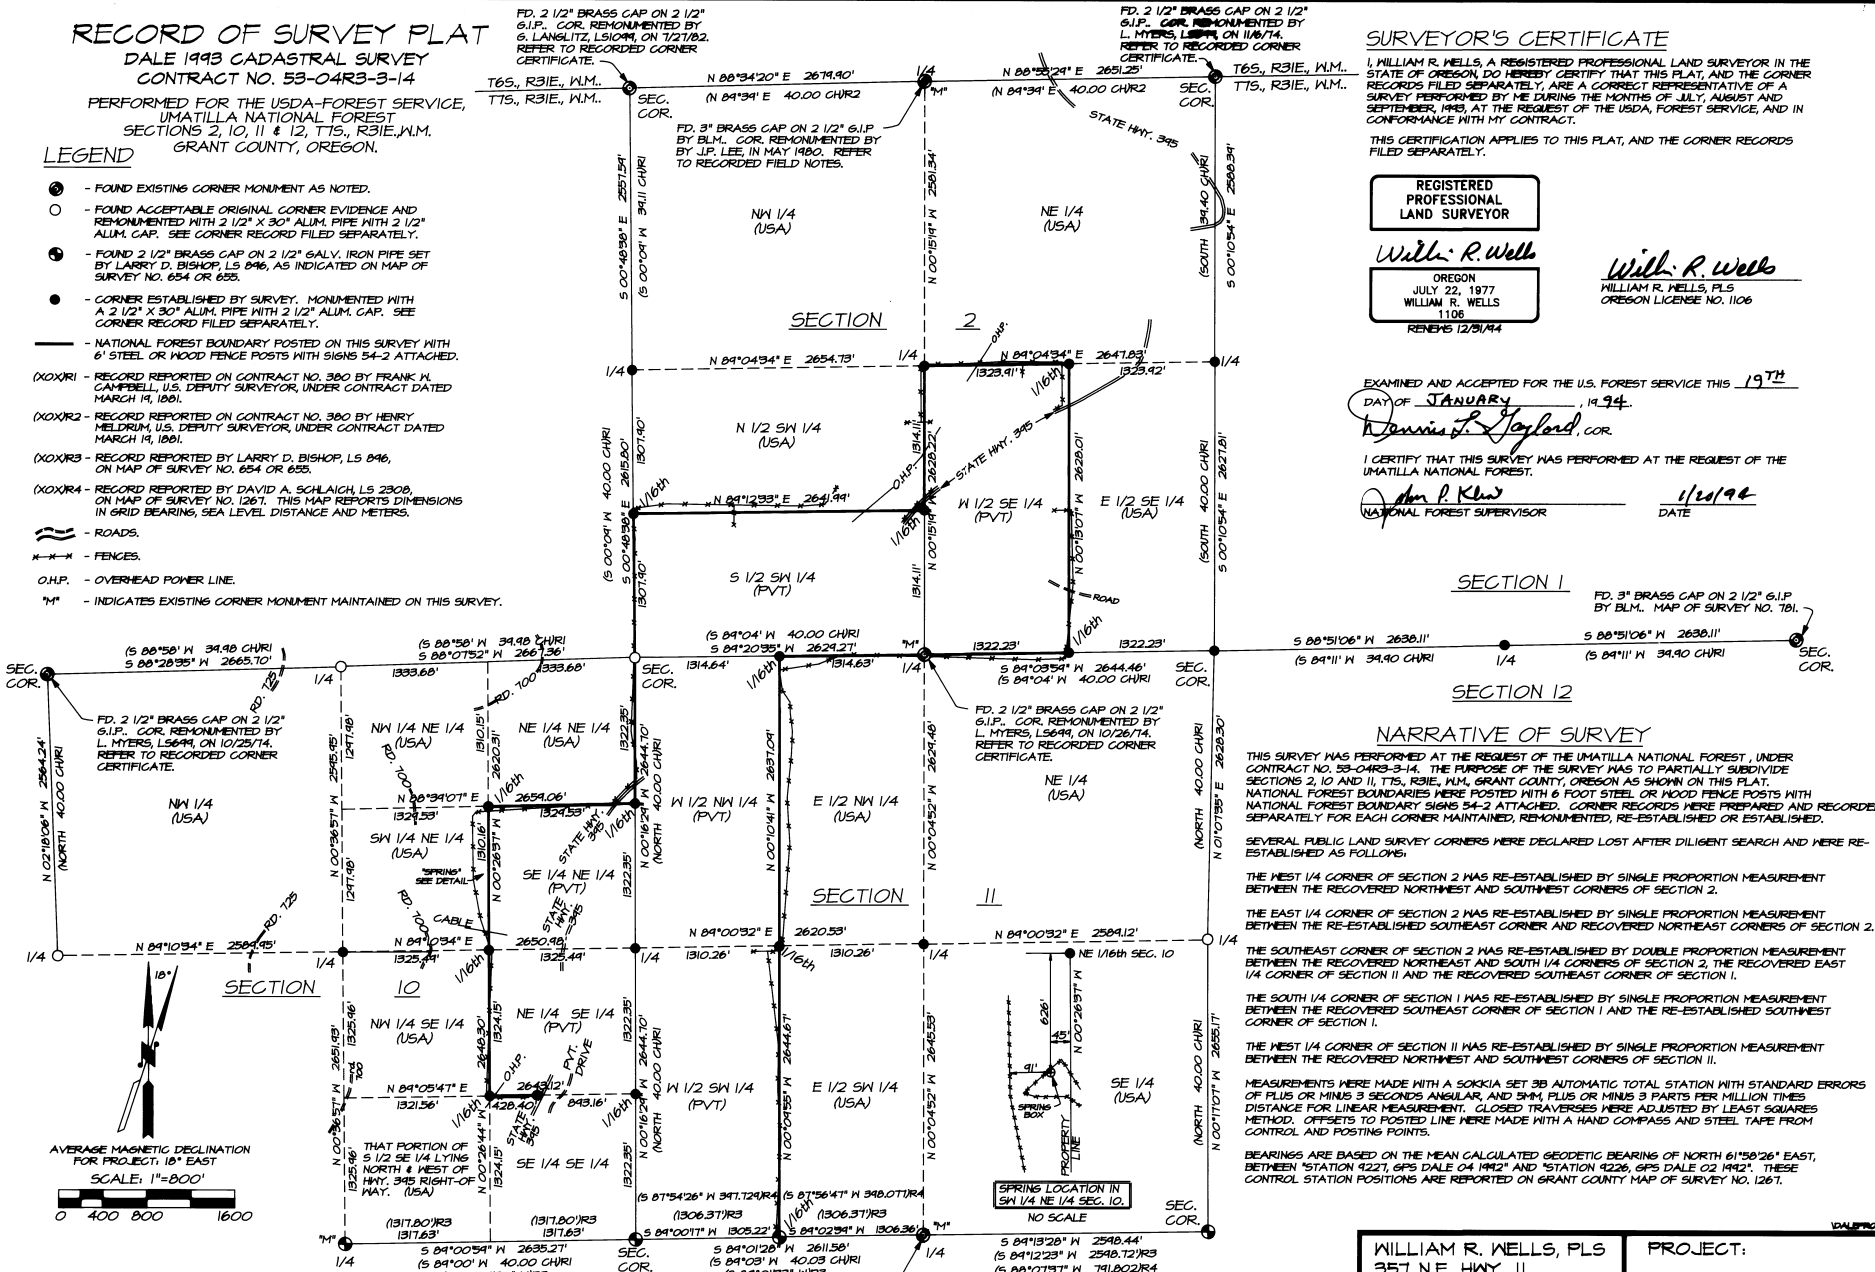

SURVEYOR'S CERTIFICATE


THIS CERTIFICATION APPLIES TO THIS PLAT, AND THE CORNER RECORDS FILED SEPARATELY.

REGISTERED PROFESSIONAL LAND SURVEYOR

Will. R. Wells

OREGON
JULY 22, 1977
WILLIAM R. WELLS
1108

Will. R. Wells
WILLIAM R. WELLS, PLS
OREGON LICENSE NO. 1106


James L. Jayford, COR.

I CERTIFY THAT THIS SURVEY WAS PERFORMED AT THE REQUEST OF THE UMATILLA NATIONAL FOREST.

NATIONAL FOREST SUPERVISOR DATE

NARRATIVE OF SURVEY

THIS SURVEY WAS PERFORMED AT THE REQUEST OF THE UMATILLA NATIONAL FOREST, UNDER CONTRACT NO. 53-04R3-3-14. THE PURPOSE OF THE SURVEY WAS TO PARTIALLY SUBDIVIDE SECTIONS 2, 10 AND 11, T7S., R31E., W.M., GRANT COUNTY, OREGON AS SHOWN ON THIS PLAT. NATIONAL FOREST BOUNDARIES WERE POSTED WITH 6 FOOT STEEL OR WOOD FENCE POSTS WITH NATIONAL FOREST BOUNDARY SIGNS 54-2 ATTACHED. CORNER RECORDS WERE PREPARED AND RECORDED SEPARATELY FOR EACH CORNER MAINTAINED, RE-MONUMENTED, RE-ESTABLISHED OR ESTABLISHED.

SEVERAL PUBLIC LAND SURVEY CORNERS WERE DECLARED LOST AFTER DILIGENT SEARCH AND WERE RE-ESTABLISHED AS FOLLOWS:

- THE WEST 1/4 CORNER OF SECTION 2 WAS RE-ESTABLISHED BY SINGLE PROPORTION MEASUREMENT BETWEEN THE RECOVERED NORTHWEST AND SOUTHWEST CORNERS OF SECTION 2.
- THE EAST 1/4 CORNER OF SECTION 2 WAS RE-ESTABLISHED BY SINGLE PROPORTION MEASUREMENT BETWEEN THE RE-ESTABLISHED SOUTHEAST CORNER AND RECOVERED NORTHEAST CORNERS OF SECTION 2.
- THE SOUTHEAST CORNER OF SECTION 2 WAS RE-ESTABLISHED BY DOUBLE PROPORTION MEASUREMENT BETWEEN THE RECOVERED NORTHEAST AND SOUTH 1/4 CORNERS OF SECTION 2, THE RECOVERED EAST 1/4 CORNER OF SECTION II AND THE RECOVERED SOUTHEAST CORNER OF SECTION I.
- THE SOUTH 1/4 CORNER OF SECTION I WAS RE-ESTABLISHED BY SINGLE PROPORTION MEASUREMENT BETWEEN THE RECOVERED SOUTHEAST CORNER OF SECTION I AND THE RE-ESTABLISHED SOUTHWEST CORNER OF SECTION I.
- THE WEST 1/4 CORNER OF SECTION II WAS RE-ESTABLISHED BY SINGLE PROPORTION MEASUREMENT BETWEEN THE RECOVERED NORTHWEST AND SOUTHWEST CORNERS OF SECTION II.

MEASUREMENTS WERE MADE WITH A SOKKIA SET 383 AUTOMATIC TOTAL STATION WITH STANDARD ERRORS OF PLUS OR MINUS 3 SECONDS ANGULAR, AND 5MM PLUS OR MINUS 3 PARTS PER MILLION TIMES DISTANCE FOR LINEAR MEASUREMENT. CLOSED TRAVERSES WERE ADJUSTED BY LEAST SQUARES METHOD. OFFSETS TO POSTED LINE WERE MADE WITH A HAND COMPASS AND STEEL TAPE FROM CONTROL AND POSTING POINTS.


HISTORY OF SURVEYS

THE NORTH LINE OF TOWNSHIP 7 SOUTH, RANGE 31 EAST, W.M., WAS SURVEYED BY HENRY MELDRUM, U.S. DEPUTY SURVEYOR, UNDER CONTRACT NO. 380, DATED MARCH 19, 1881.

THE SUBDIVISIONS OF TOWNSHIP 7 SOUTH, RANGE 31 EAST WERE MADE BY FRANK W. CAMPBELL, U.S. DEPUTY SURVEYOR, UNDER CONTRACT NO. 380, DATED MARCH 19, 1881.

IN 1980 AND 1981, LARRY D. BISHOP, LS. 846, UNDER USDA-FOREST SERVICE CONTRACT NO. 53-04R3-0-01147, SUBDIVIDED SECTIONS 14 AND 15 AND MONUMENTED CERTAIN CORNERS.

| | | | |
|--|-------------|--|------------|
| WILLIAM R. WELLS, PLS 357 N.E. HWY. 11 P.O. BOX 1696 PENDLETON, OR 97801 PHONE: (503) 276-6362 | | PROJECT: DALE 1993 CADASTRAL SURVEY CONTRACT NO. 53-04R3-3-14 | |
| DATE: 12/8/73 | DR. BY: WEG | CK. BY: WRM | NO: 43-123 |

Umatilla County Surveyor
Date: 2-74
KR
94-01-B