


N.W. 1/4 OF SEC. 13, T.6N., R.35E., W.M.,
UMATILLA COUNTY, OREGON

SCALE 1:500

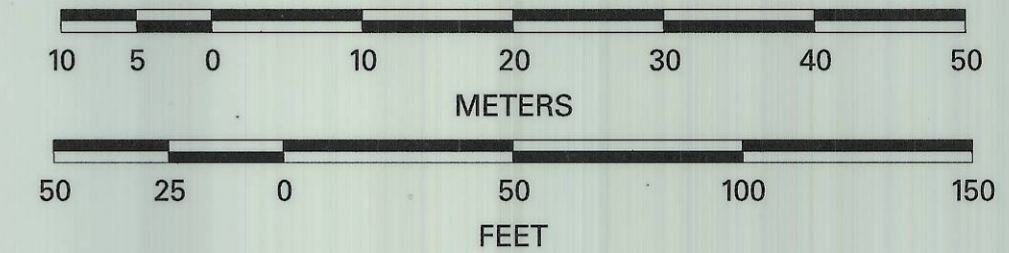

WASHINGTON
WALLA WALLA
COUNTY

"SL" 0+160.000 P.O.T.
N. 261,522.666
E. 2,663,581.470
Held per D.N. 10B-14-23

Centerline of relocated State
Line Road per D.N. 10B-14-23

STATE LINE ROAD
N.88°43'51"E. "SL"

ODOT File 6853-001
Document No. 2001-3940107
Document No. 2001-3940108
Document No. 2001-3940109
Document No. 2001-3940110

"SL" 0+304.800 P.O.T.
N. 261,525.873
E. 2,663,726.234
Held per D.N. 10B-14-23

ODOT File 6853-002
Document No. 2001-3930299

0+374.036
6.756m Rt
N=261,520.652
E=2,663,795.603
Set as reference
point only

"SL" 0+430.000 P.O.T.
N. 261,528.646
E. 2,663,891.403
Held per
D.N. 10B-14-23

N.88°41'42"E. Per S.N. 96-56-B

N.88°38'57"E. Per S.N. 00-111-B

N.88°43'51"E. "SL"

0+160.000
7.013m Rt
N=261,515.655
E=2,663,581.625

0+180.000
13.000m Rt
N=261,510.112
E=2,663,601.753

Fd. 1/4 Section Corner
89 mm (3-1/2") Brass Disk in
damaged monument box (3/1/2000)
Not searched for this survey.

Set 16mm x 760mm (5/8"x30")
Iron Rod with Red Plastic
Cap inscribed "OTAK CONTROL"
(11/13/2002)
N. 261,512.239
E. 2,663,702.759

0+283.000
16.000m Rt
N=261,509.394
E=2,663,704.794

0+289.832
38.000m Rt
N=261,487.551
E=2,663,712.112

0+300.000
38.000m Rt
N. 1°40'54"W. Held per S.N. 00-111-B

0+310.000
23.000m Rt

0+320.205
23.000m Rt
N=261,503.220
E=2,663,742.145

Otto A. Karrels
R-275-833

This property line
not surveyed

REGISTERED
PROFESSIONAL
LAND SURVEYOR

John A. CL

OREGON
JULY 15, 1983
JOHN A. CARLSON
2044

RENEWS 12-31-2003

NARRATIVE:

The purpose of this survey was to monument the new right-of-way of State Line Road at the intersection of State Line Road and Highway 11 per ODOT Drawing Number 10B-14-23 and ODOT Project Number 6853 right-of-way acquisition deeds.

BEARINGS: Oregon Coordinate System of 1983, north zone per Survey No. 00-111-B.

COORDINATES: Held Survey No. 00-111-B Local Datum Plane (LDP) coordinate values for control points 1, 2, 3, and 4. To convert the LDP coordinates to the Oregon Coordinate System of 1983, north zone, multiply the LDP coordinates by 0.99996431.

PROCEDURES: The LDP coordinates for control points 1 - 4 as shown on Survey No. 00-111-B and ODOT Drawing No. 10B-14-23 are identical. I held the Drawing No. 10B-14-23 coordinate values for the center line of relocated State Line Road, and set monuments at the angle points in the new right-of-way so as to conform to the station and offset data as shown on Drawing No. 10B-14-23 and the above referenced deeds.

Umatilla County Surveyor
Date 01-03
Red'd By KK
No. 03-04-B

TO CONVERT METERS TO FEET DIVIDE BY 0.3048

RECORD OF SURVEY FOR
OREGON DEPT. OF TRANSPORTATION
REGION 5
HIGHWAY 11 AT STATE LINE ROAD
MILTON - FREEWATER
LOCATED IN THE N.W. 1/4
OF SECTION 13, T.6N., R.35E., W.M.
UMATILLA COUNTY, OREGON



17355 SW Boones Ferry Rd.
Lake Oswego, Oregon 97035
Phone: (503) 635-3618
FAX: (503) 635-5395

DECEMBER 23, 2002
SHEET 1 OF 1




REGION 5

OREGON
UMATILLA COUNTY

LOT 4

GRANDVIEW
ORCHARD

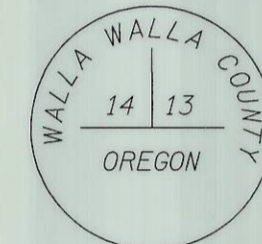

N. 261,520.068
E. 2,663,641.548

CONTROL AND BASIS OF BEARING

#3
Fd. 83 mm (3-1/4") Brass Cap
in concrete (11/13/2002)



N. 261,526.765
E. 2,663,543.534
Held per S.N. 00-111-B

Set 16mm x 760mm (5/8"x30")
Iron Rod with Red Plastic
Cap inscribed "OTAK CONTROL"
(11/13/2002)
N. 261,512.239
E. 2,663,702.759

#4
Fd. 83 mm (3-1/4") Brass Cap
in concrete (11/13/2002)



N. 261,666.136
E. 2,663,734.497
Held per S.N. 00-111-B

Fd. N. 1/4 Section Corner
16 mm (5/8") Iron Rod
(3/1/00)
N. 261,531.449
E. 2,664,124.229
(Per S.N. 00-111-B)
Not searched for
this survey.

Fd. 1/4 Section Corner
89 mm (3-1/2") Brass Disk
in damaged monument box (3/1/00)
Not searched for this survey.



N. 261,520.068
E. 2,663,641.548
(Per S.N. 00-111-B)

#2
Fd. 83 mm (3-1/4") Brass Cap
in concrete (11/13/2002)



N. 261,393.986
E. 2,663,716.184
Held per S.N. 00-111-B

#1
Fd. 83 mm (3-1/4") Brass Cap
in concrete (11/13/2002)



N. 261,532.530
E. 2,663,890.475
Held per S.N. 00-111-B

LEGEND

- SET 16mm x 760mm (5/8"x30") IRON ROD W/ ALUMINUM CAP INSCRIBED "OTAK, INC." ON 11/13/2002.
- ▲ SET 16mm x 760mm (5/8"x30") IRON ROD W/ RED PLASTIC CAP INSCRIBED "OTAK CONTROL"
- FOUND MONUMENT AS SHOWN
- ☆ FOUND GPS CONTROL POINT PER SURVEY NO. 00-111-B
- m METERS
- S.N. DENOTES SURVEY NUMBER, UMATILLA COUNTY SURVEY RECORDS
- D.N. DENOTES ODOT RIGHT-OF-WAY DRAWING

NO SCALE