

**NARRATIVE:**

THE PURPOSE OF THIS SURVEY IS TO STAKE A PORTION OF THAT TRACT OF LAND DEEDED TO SAM WHITLOCK ON REEL 335, PAGE 614, FOR A PENDING SALE.

I SURVEYED THE EAST LINE OF THIS TRACT AND SOME EASEMENTS IN A 2003 SURVEY FOR JOHNS. IN THAT SURVEY I USED FOUND MONUMENTS WHICH WERE SET FOR PROPERTY CORNERS BUT DID NOT MATCH DESCRIPTIONS. I REWROTE DESCRIPTIONS OF THE PROPERTIES TO THE EAST OF THIS TRACT TO MATCH THOSE OLD MONUMENTS. IN THIS SURVEY THE WEST LINE IS EASY TO DEFINE BUT THE SOUTH LINE IS CALLED TO THE NORTH LINE OF JOHN'S TRACT WHICH IN TURN IS CALLED AS PARALLEL WITH THE NORTH LINE OF BUSHBY'S TRACT. BUSHBY'S NE CORNER CALLS FOR AN IRON PIN WHICH I COULD NOT FIND SO I TIED AND USED A RAILROAD TIE FENCE CORNER AS THE BEST EVIDENCE OF THE NORTH LINE OF BUSHBY'S TRACT. THAT WAS CONFIRMED BY A FENCE LINE ALONG THE LINE WHICH DIVIDES JOHN AND WHITLOCK.


THIS SURVEY WAS ACCOMPLISHED USING A TOPCON GPS HYPER SYSTEM AND ROTATED TO MATCH MY 2003 JOHN SURVEY. A SOKKIA SET 300 TOTAL STATION WAS USED TO SET MONUMENTS FROM CONTROL POINTS.

REGISTERED PROFESSIONAL LAND SURVEYOR

*G. Dennis Edwards*

OREGON  
JULY 16, 1971  
G. DENNIS EDWARDS  
9 5 1  
RENEWS 12/31/2005

- LEGEND:**
- FOUND MONUMENTS AS NOTED
  - SET 5/8"X30" IRON REBAR WITH PLASTIC CAP #951
  - COMPUTED FROM MY 2003 SURVEY FOR JOHNS
  - (000) OF RECORD,
  - C COMPUTED
  - [000] DEED RECORD,

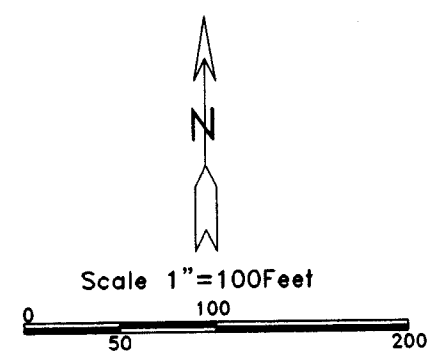

SURVEY FOR HOMECOMINGS FINANCIAL, % AMERICAN WEST REALTY  
IN SE 1/4, SEC. 14, T 5 N, R 27 E, W.M.,  
UMATILLA COUNTY, OREGON  
6/15/2004 JOB# S0406114  
EDWARDS SURVEYING P.O. BOX 763  
541-567-3336 HERMISTON, OREGON 97838  
DRAWN BY NJF

04-154-B  
Umatilla County Surveyor  
Date 8-04  
Rec'd By KR  
No. 04-154-B