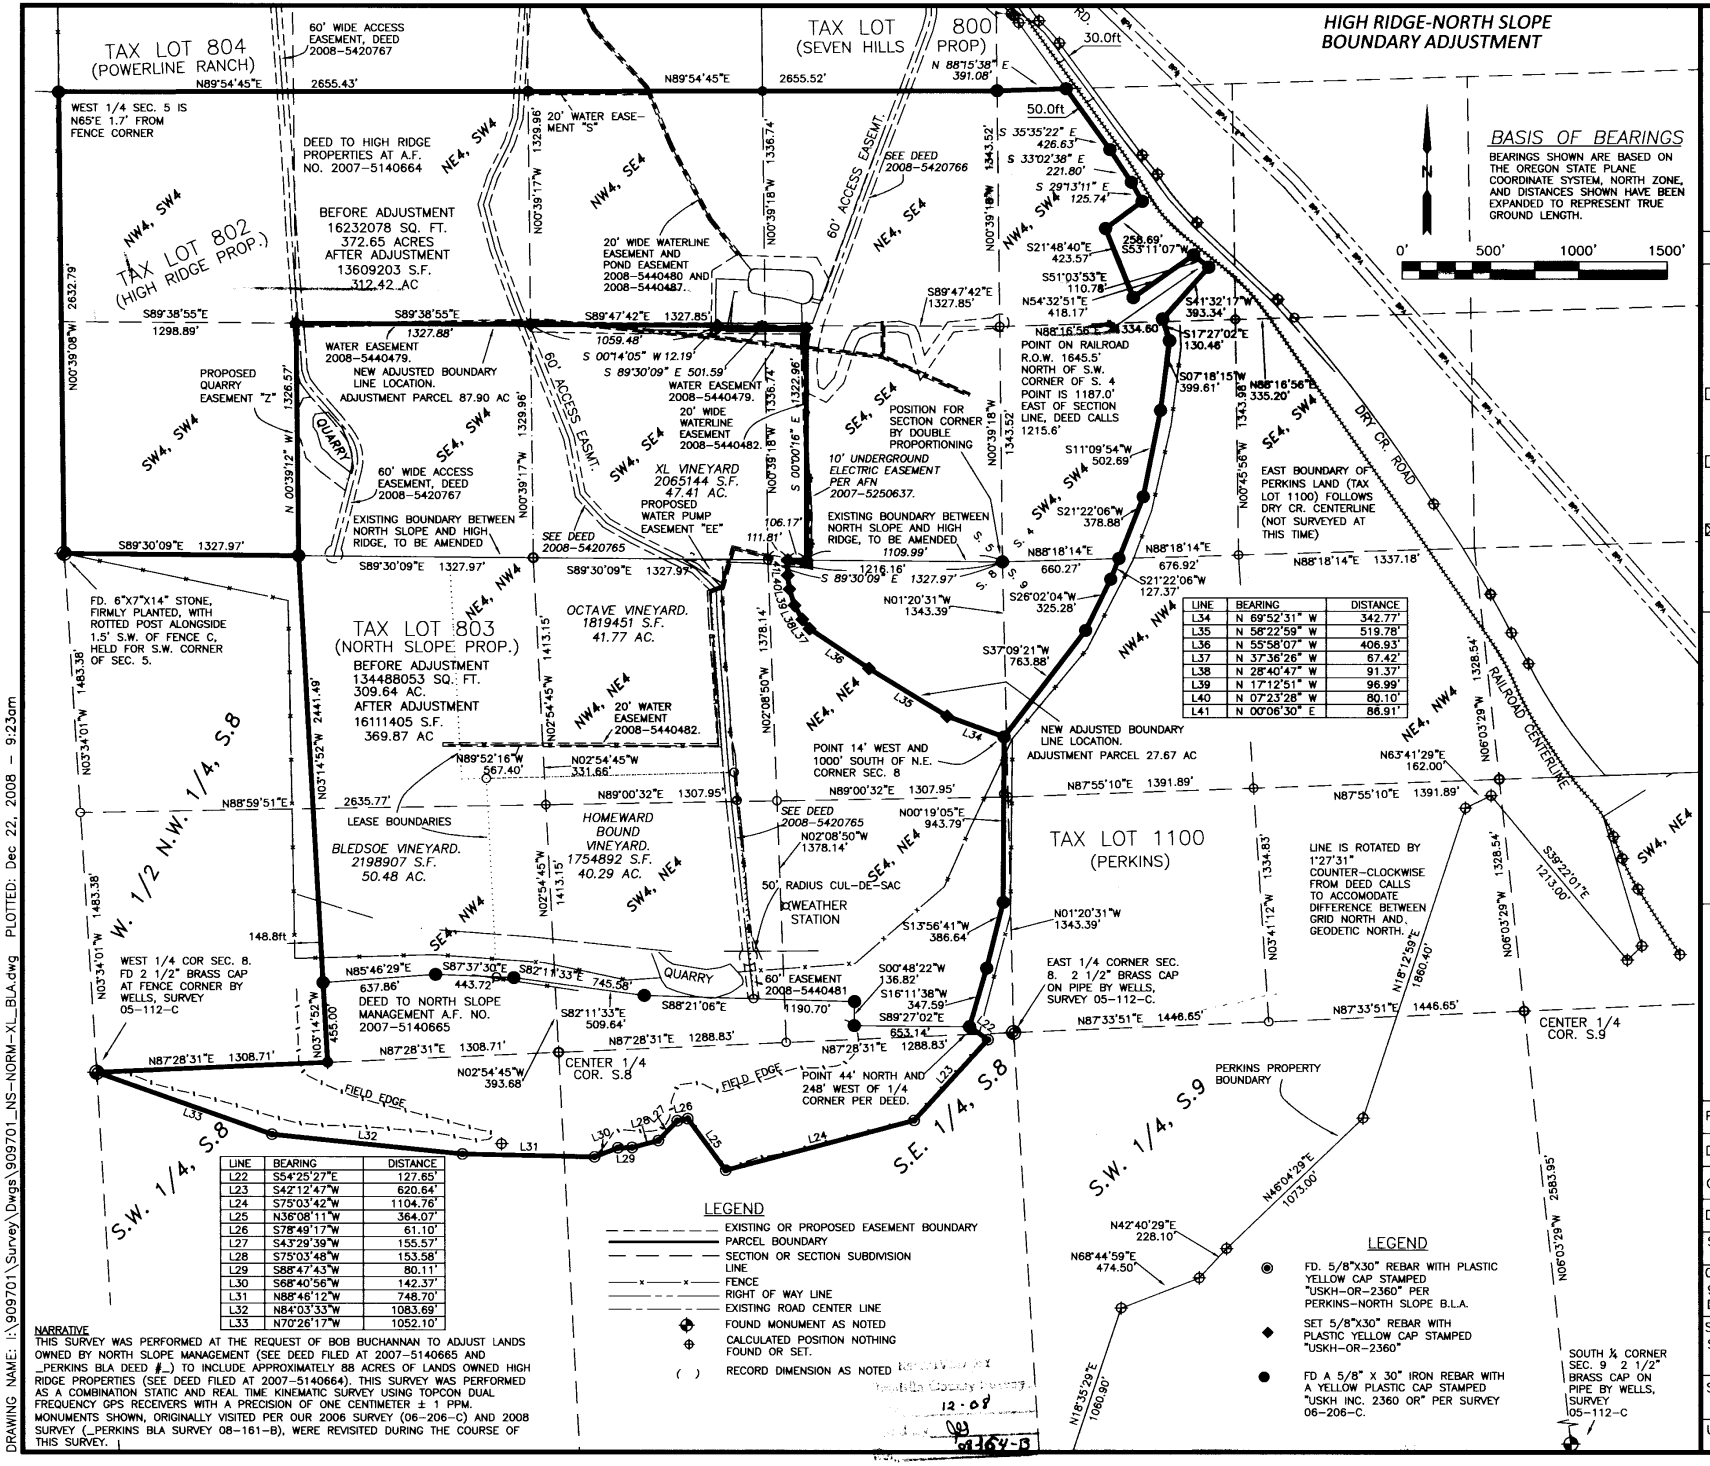

LINE	BEARING	DISTANCE
L34	N 69°52'31" W	342.77'
L35	N 58°22'59" W	519.78'
L36	N 55°58'07" W	406.93'
L37	N 37°36'26" W	67.42'
L38	N 28°40'47" W	91.37'
L39	N 17°12'51" W	96.99'
L40	N 07°23'28" W	80.10'
L41	N 00°06'30" E	86.91'

LINE	BEARING	DISTANCE
L22	S54°25'27"E	127.85'
L23	S42°12'47"W	620.64'
L24	S75°03'42"W	1104.76'
L25	N36°08'11"W	364.07'
L26	S78°49'17"W	61.10'
L27	S43°29'39"W	155.57'
L28	S75°03'48"W	153.58'
L29	S88°47'43"W	80.11'
L30	S68°40'56"W	142.37'
L31	N88°46'12"W	748.70'
L32	N84°03'33"W	1083.69'
L33	N70°26'17"W	1052.10'

NARRATIVE
THIS SURVEY WAS PERFORMED AT THE REQUEST OF BOB BUCHANNAN TO ADJUST LANDS OWNED BY NORTH SLOPE MANAGEMENT (SEE DEED FILED AT 2007-5140665 AND _PERKINS BLA DEED #_) TO INCLUDE APPROXIMATELY 88 ACRES OF LANDS OWNED HIGH RIDGE PROPERTIES (SEE DEED FILED AT 2007-5140664). THIS SURVEY WAS PERFORMED AS A COMBINATION STATIC AND REAL TIME KINEMATIC SURVEY USING TOPCON DUAL FREQUENCY GPS RECEIVERS WITH A PRECISION OF ONE CENTIMETER ± 1 PPM. MONUMENTS SHOWN, ORIGINALLY VISITED PER OUR 2006 SURVEY (06-206-C) AND 2008 SURVEY (_PERKINS BLA SURVEY 08-161-B), WERE REVISITED DURING THE COURSE OF THIS SURVEY.

REGISTERED PROFESSIONAL LAND SURVEYOR
Paul W.P. Tomkins
OREGON
JULY 26, 1988
PAUL W.P. TOMKINS
2360
renews 6/30/10

Date Stamped: 12/22/08

USKH
Engineering • Land Surveying
Planning • Materials Testing

☐ 313 D St. Suite 200
Lewiston, ID 83501
Phone: (208) 746-2661
Fax: (208) 746-6825

☐ 621 W. MALLON AVE. Suite. 309
Spokane, WA 99201
Phone: (509) 328-5139
Fax: (509) 328-0423

☒ 5 North Colville St.
Walla Walla, WA 99362
Phone: (509) 522-4843
Fax: (509) 522-1902

Project:
A BOUNDARY ADJUSTMENT SURVEY BETWEEN TAX LOT 802, 803 AND 1100, MAP 5N 35, BEING LOCATED IN SEC. 5, IN SEC. 8, AND IN SEC. 9, ALL IN TOWNSHIP 5 NORTH OF RANGE 35 EAST, W.M., UMATILLA COUNTY, OREGON

Client
BOB BUCHANNAN
NORTH SLOPE PROPERTIES
83501 LOWER DRY CR. RD.
MILTON FREEWATER, OR 97862

Project Mgr.	PWPT	
Drawn	TB	
Checked	PWPT	
Date	12-8-08	
Scale	1"= 500'	

CAD File: 909701_NS-NORM-XL_BLA.DWG
Sheet Contents: SURVEY MAP
Sheet No.: 1 OF 1
U.S.K.H. W.O. 909701

Umatilla County Surveyor
Date 12-08
By KK
08-161-B

DRAWING NAME: I:\909701\Survey\Dwgs\909701_NS-NORM-XL_BLA.dwg PLOTTED: Dec 22, 2008 - 9:23am