


UMAPINE  
(Formerly VINCENT)

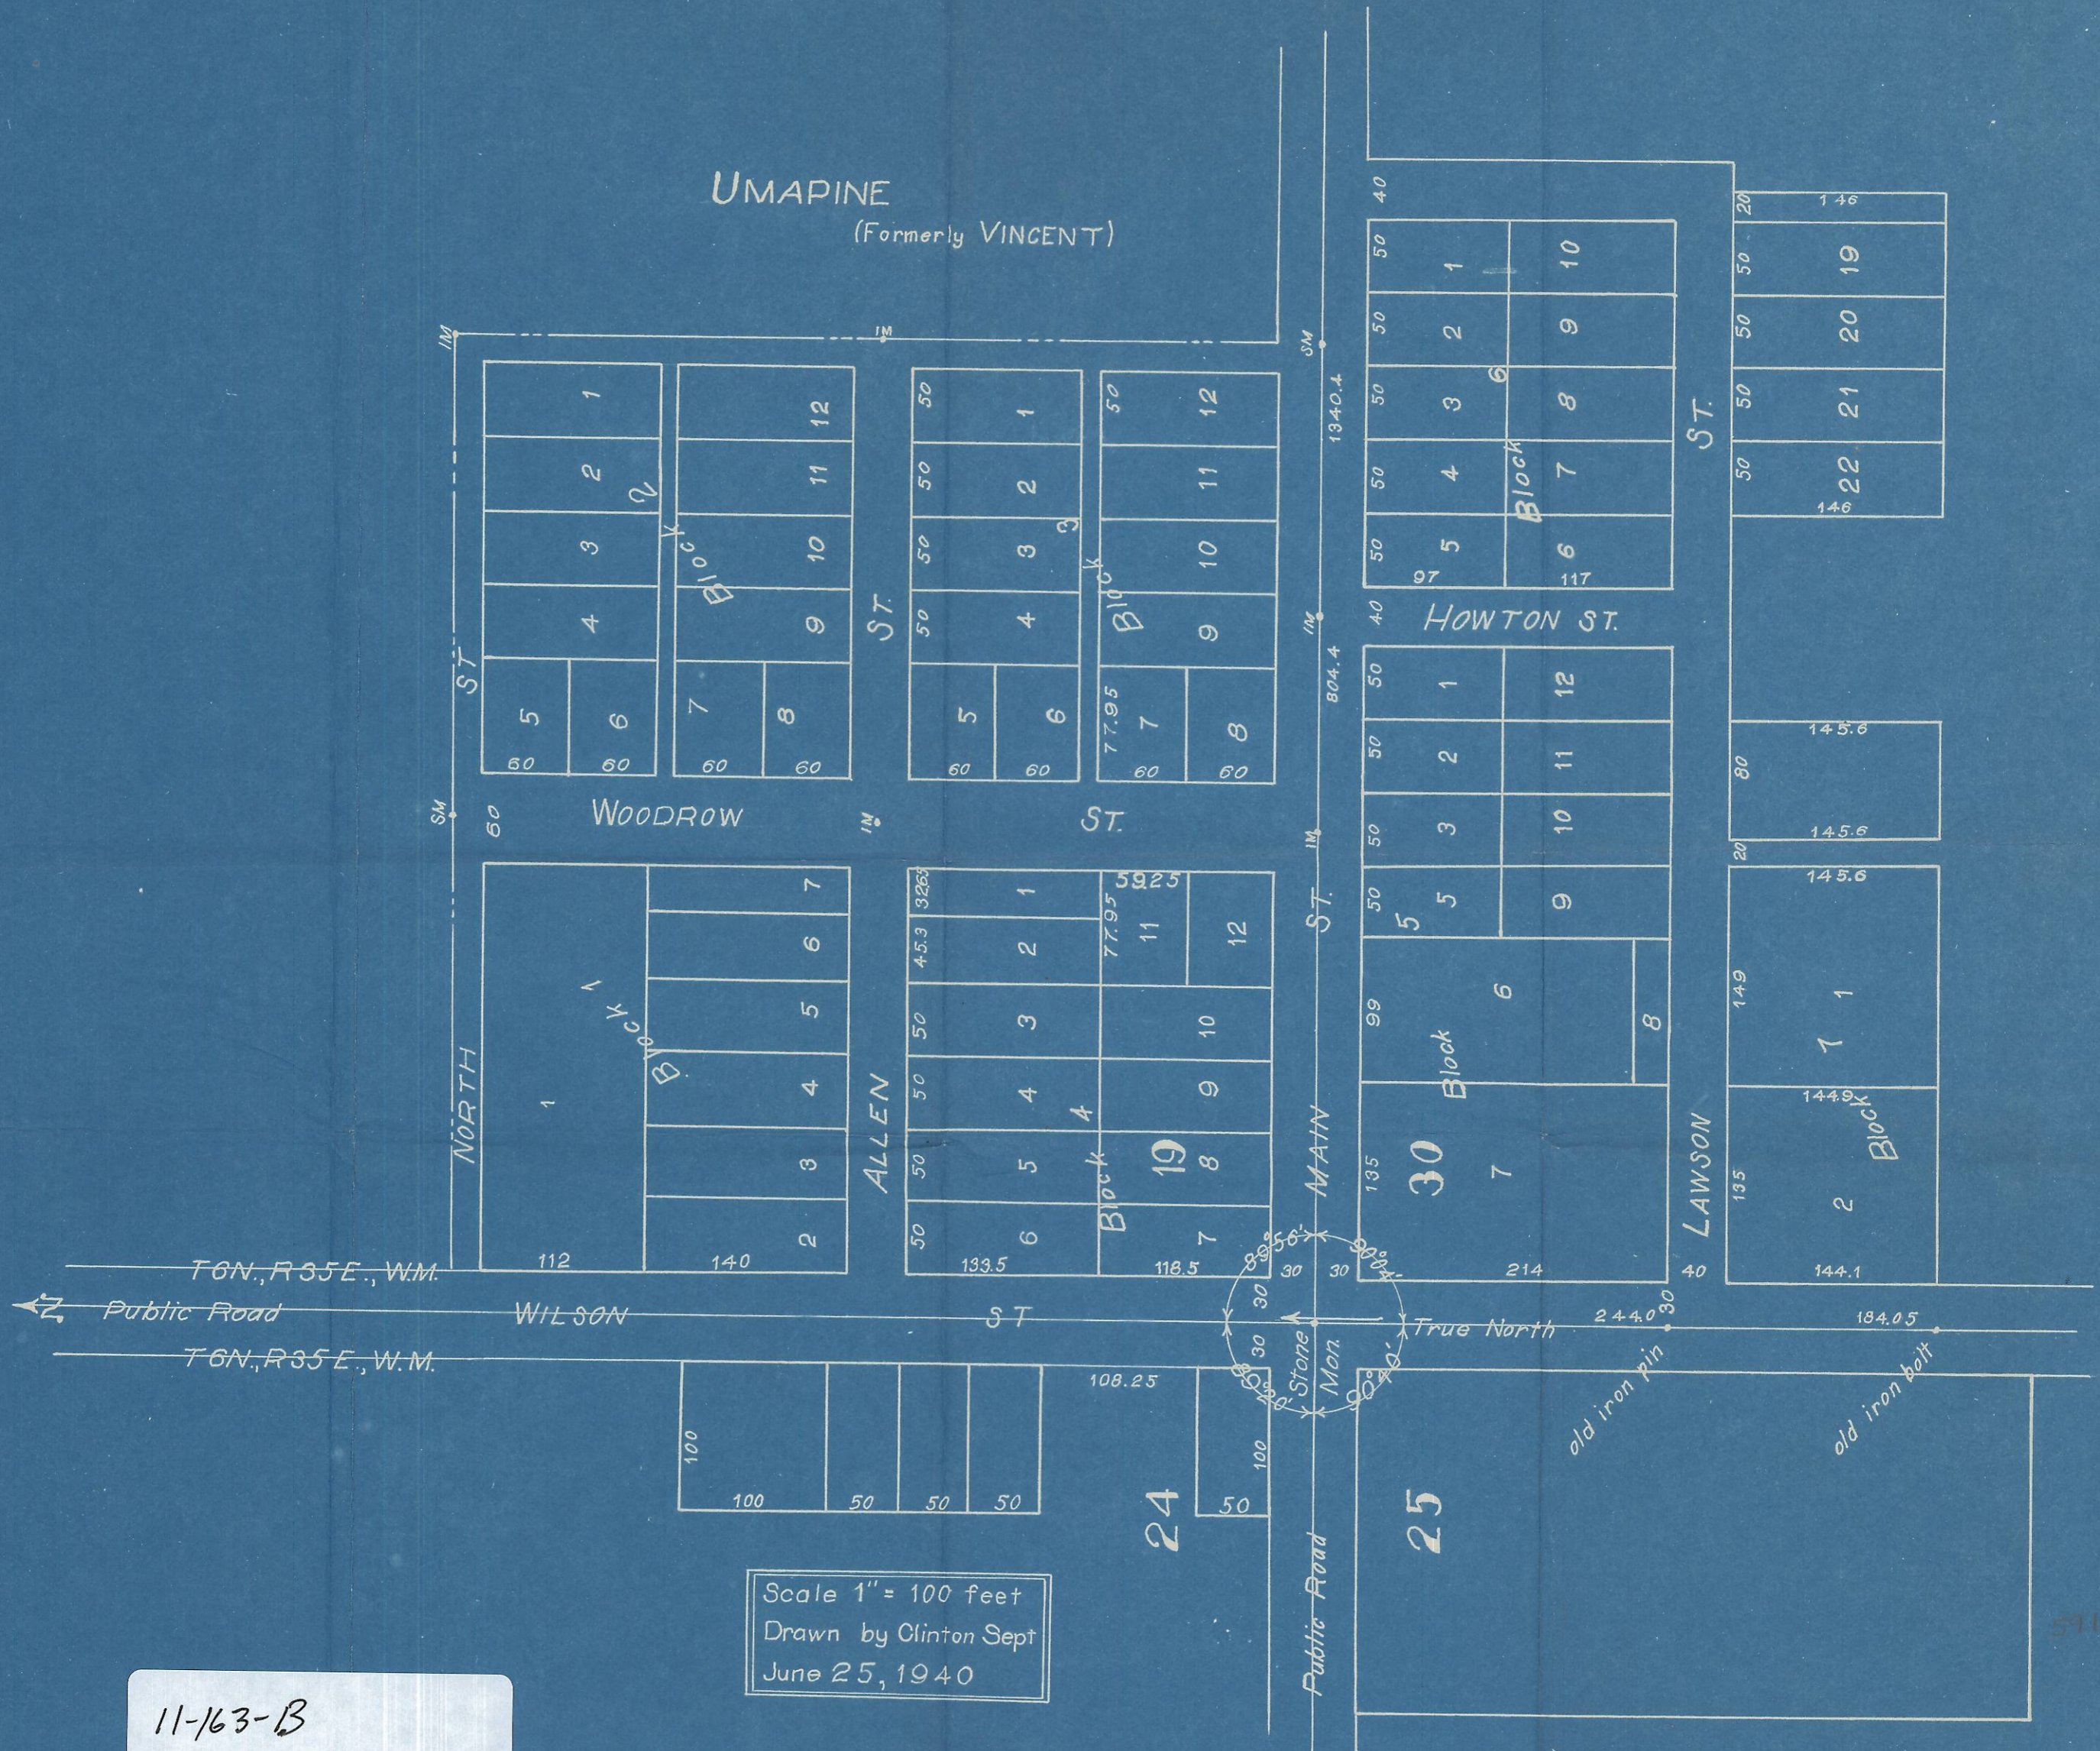

Scale 1" = 100 feet  
 Drawn by Clinton Sept  
 June 25, 1940

11-163-B  

