


SURVEY FOR
 E.A. "TONY" ROSSMEIER
 SECTION 31 T. 4N., R37E.W.M.
 Scale 1" = 100' Nov. 9, 1974

Guy W. Streamer, Jr.
 PROFESSIONAL ENGINEER

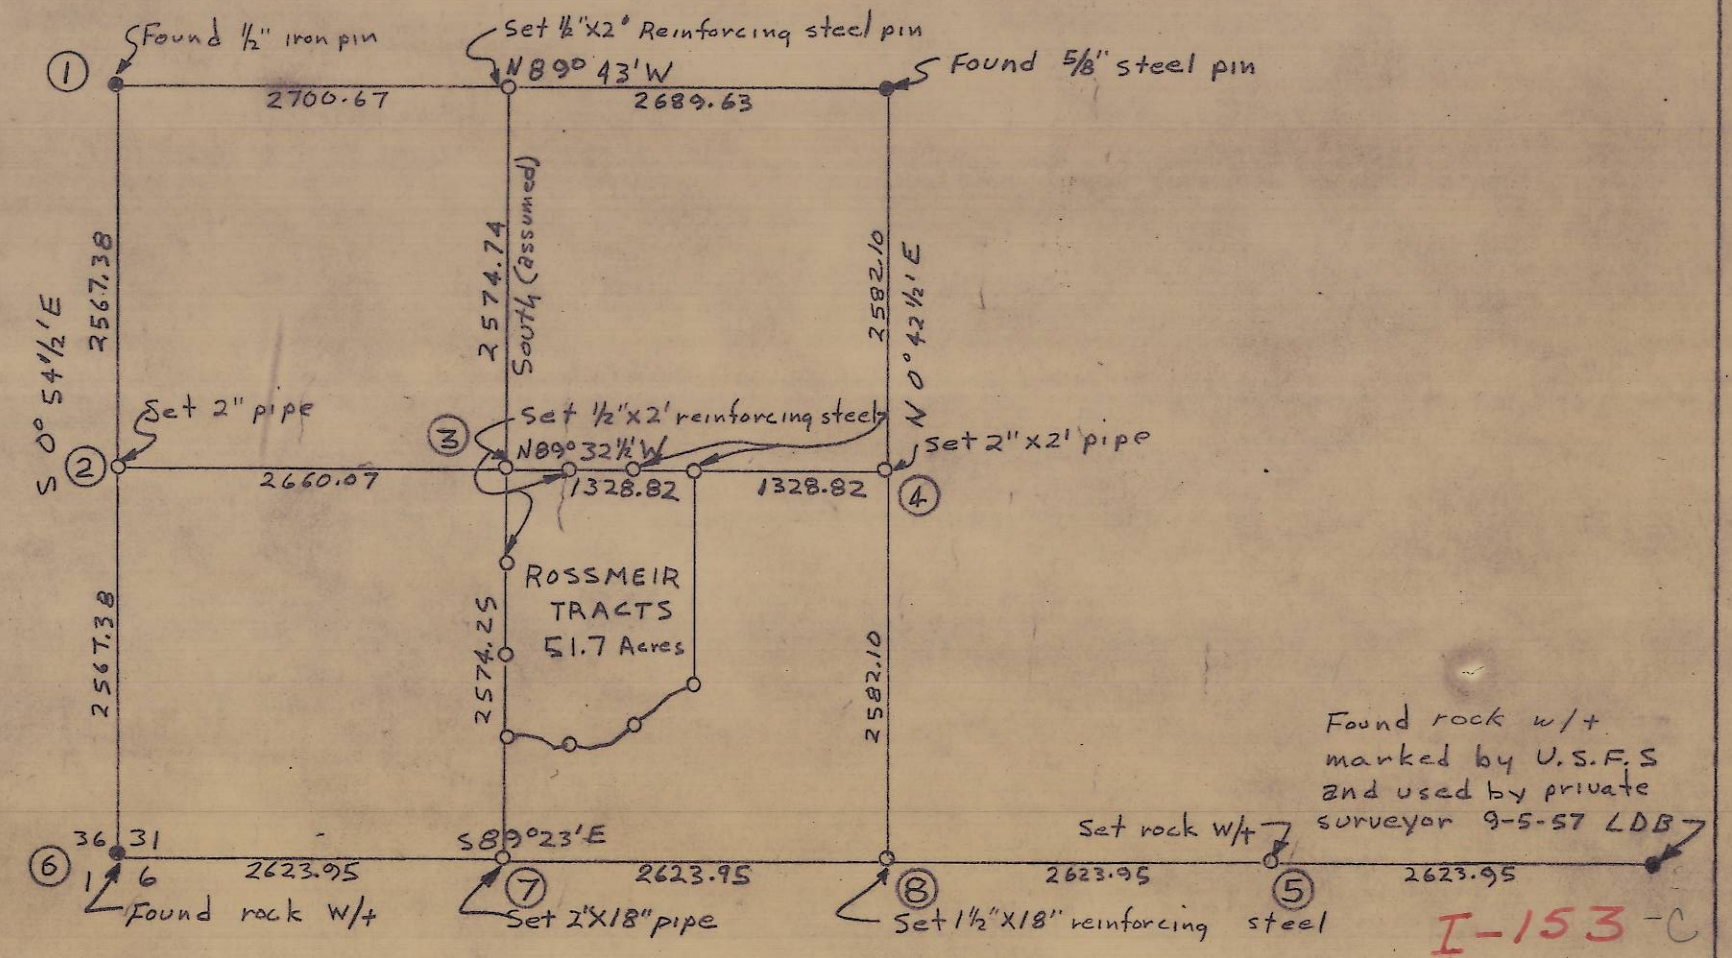

Found rock w/4
 marked by U.S.F.S
 and used by private
 surveyor 9-5-57 LDB

I-153-C
 Survey 690