
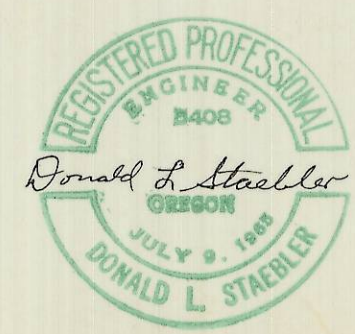


SCALE: 1" = 100'

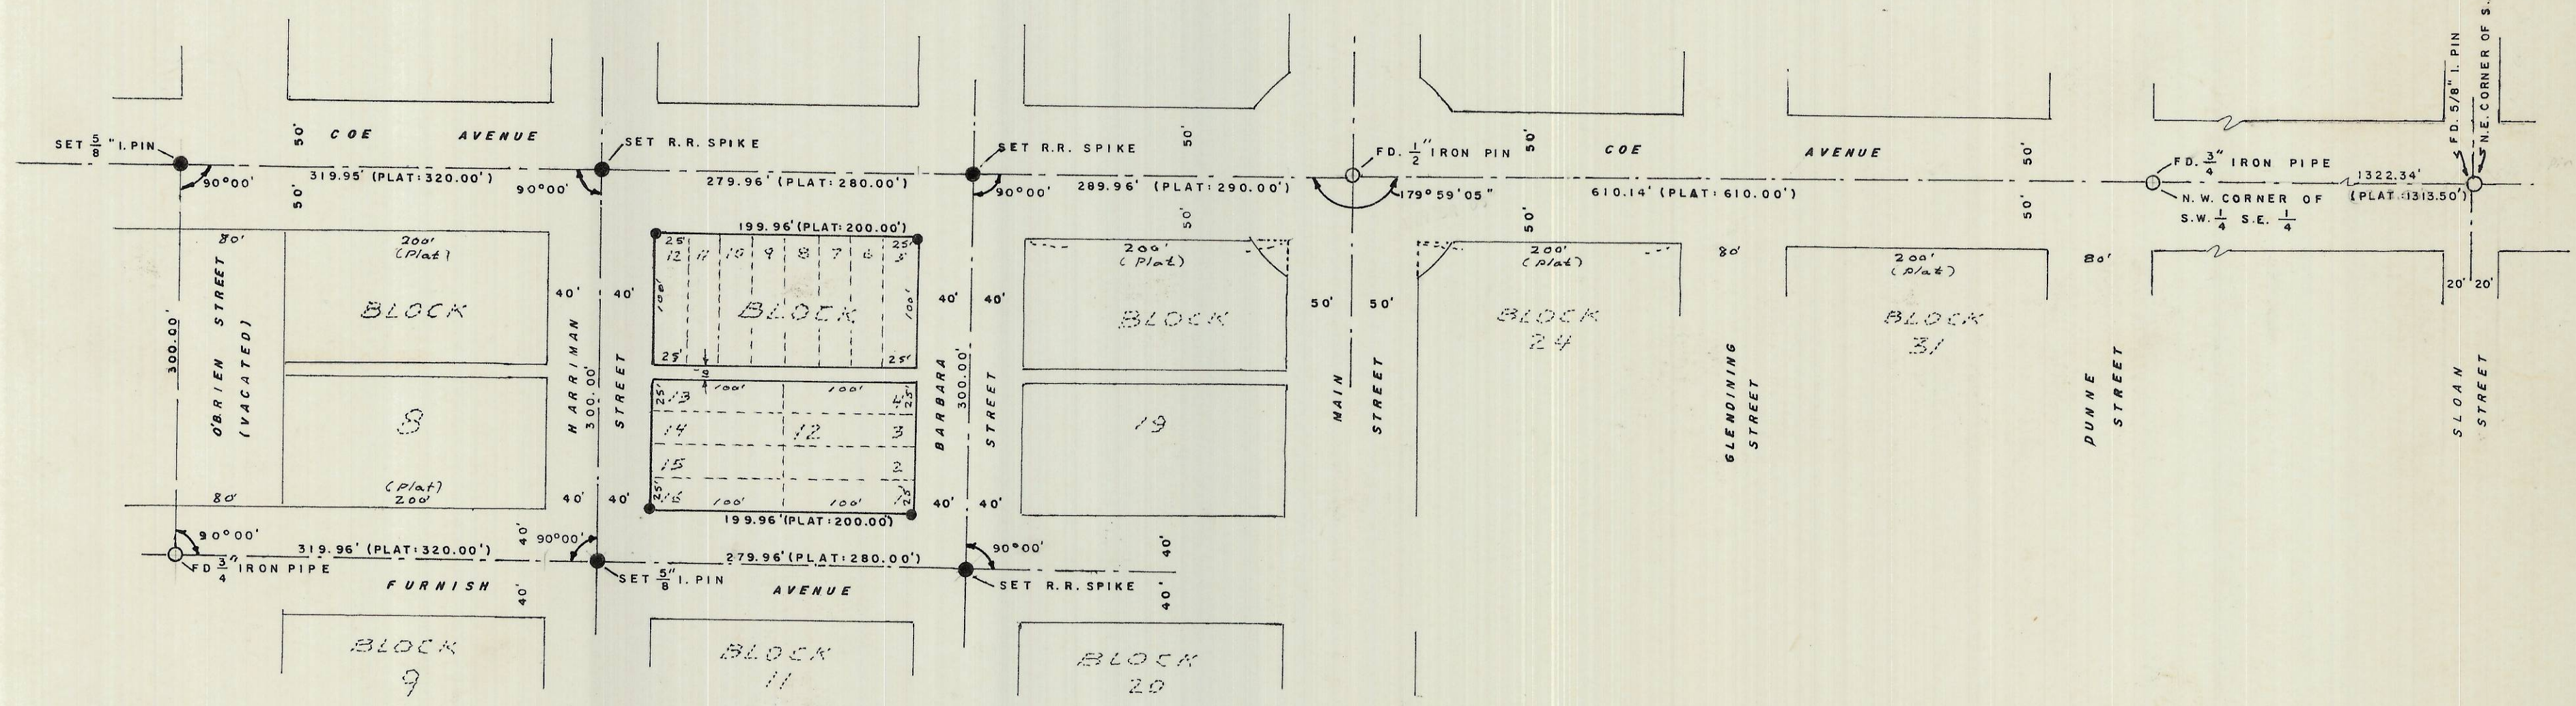

SURVEY FOR
CITY OF STANFIELD, OREGON
OF
BLOCK 12, ORIGINAL TOWN OF
STANFIELD, UMATILLA CO., OREGON

DATE: 4-28-75	SCALE: 1" = 100'
DONALD L. STAEBLER CONSULTING ENGINEER P. O. BOX 91	
PENDLETON OREGON 97801	