


SURVEY MAP
scale: 1"=50'

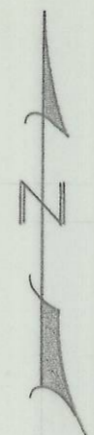


LEGEND

- Denotes iron pins found.
- Denotes 1/2" iron pins set.
- *- Denotes fence line
- + Denotes elevation points

NOTE

Elevations are relative to the finish floor elevation as shown.

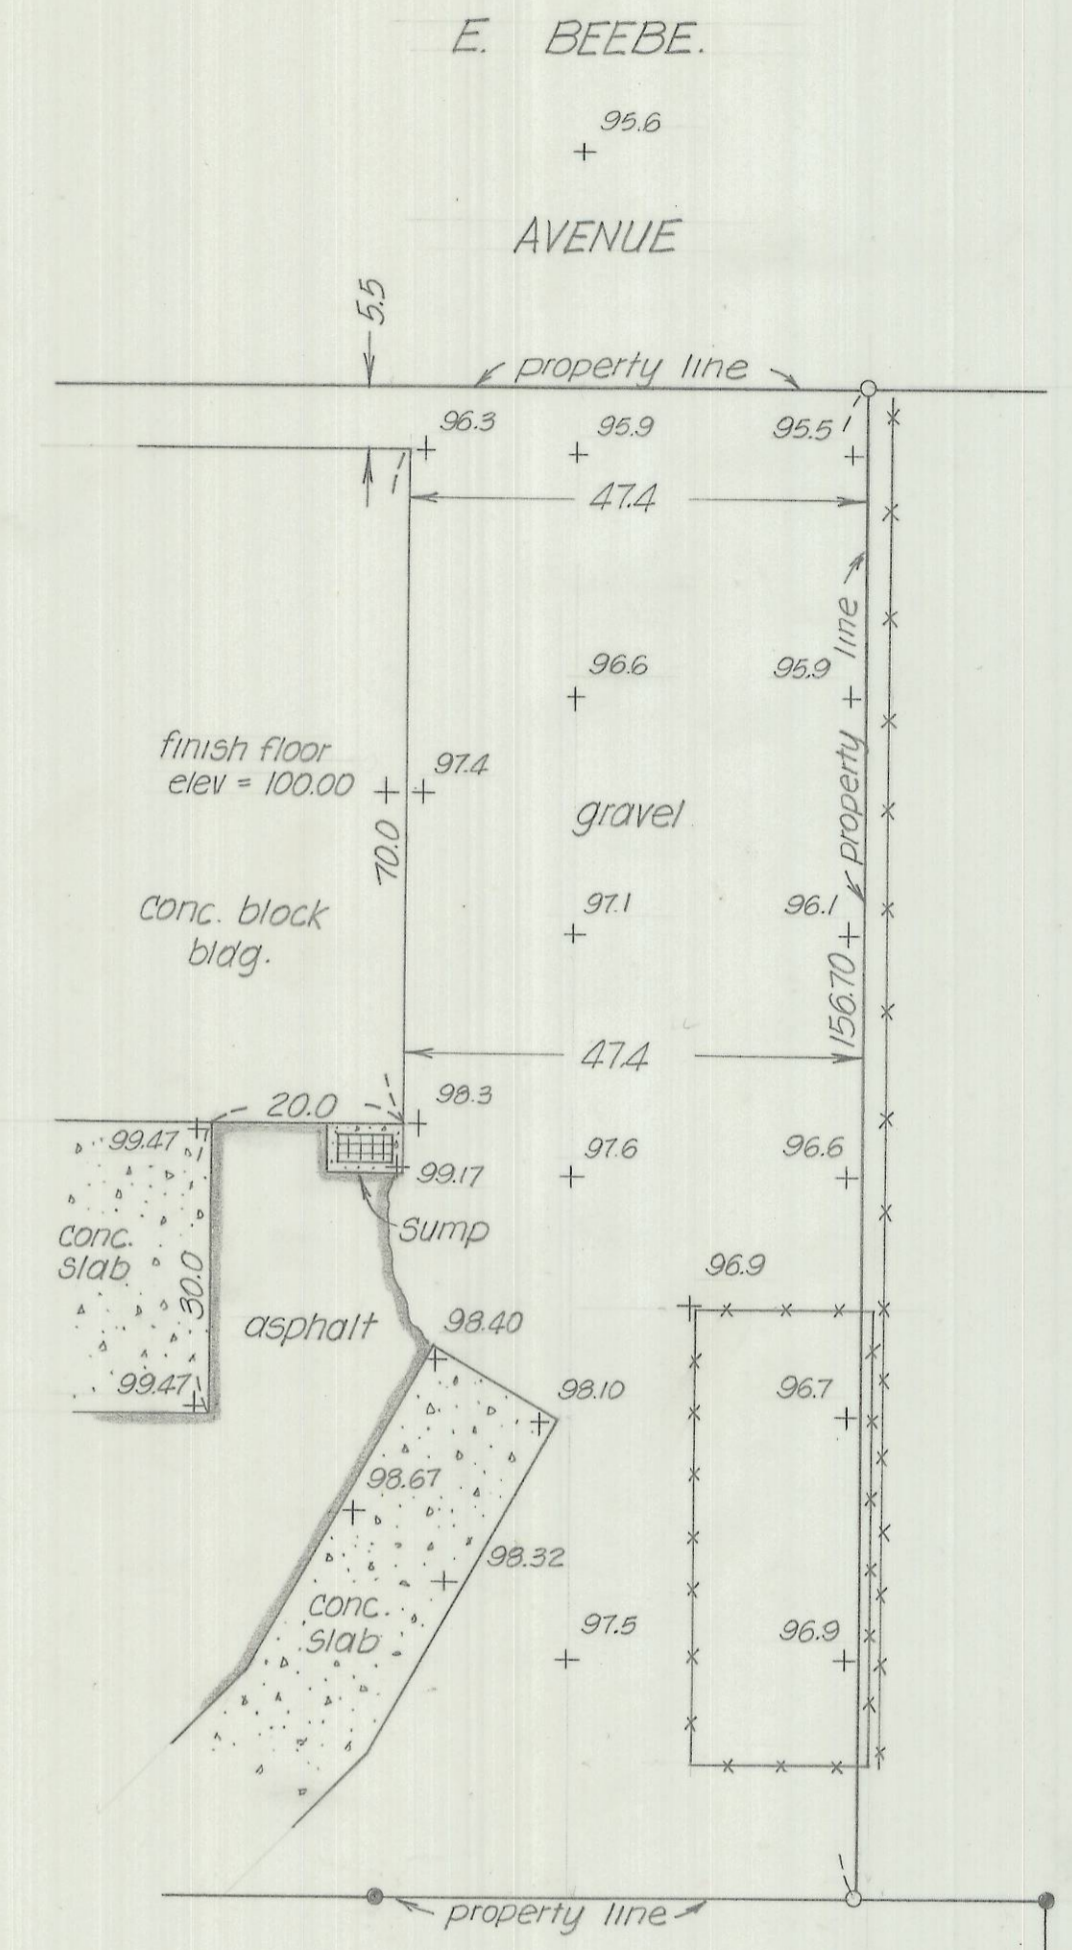

TOPOGRAPHIC MAP
scale: 1"=20'



K-17-B

SURVEY AND TOPOGRAPHIC MAP					WAYNE HARRIS CO. INC.				
for Les Schwab Tire Center,					ENGINEERS - SURVEYORS PENDLETON, OREGON				
Hermiston Ore., Sec 11, T4N, R28E					SCALE	DATE	DRG. BY	CKD BY	DRGN. NO.
					as noted	12-3-75	C.T.P.	E.J.H.	75-99B