Note:
Bearings based on John Wilson Addition

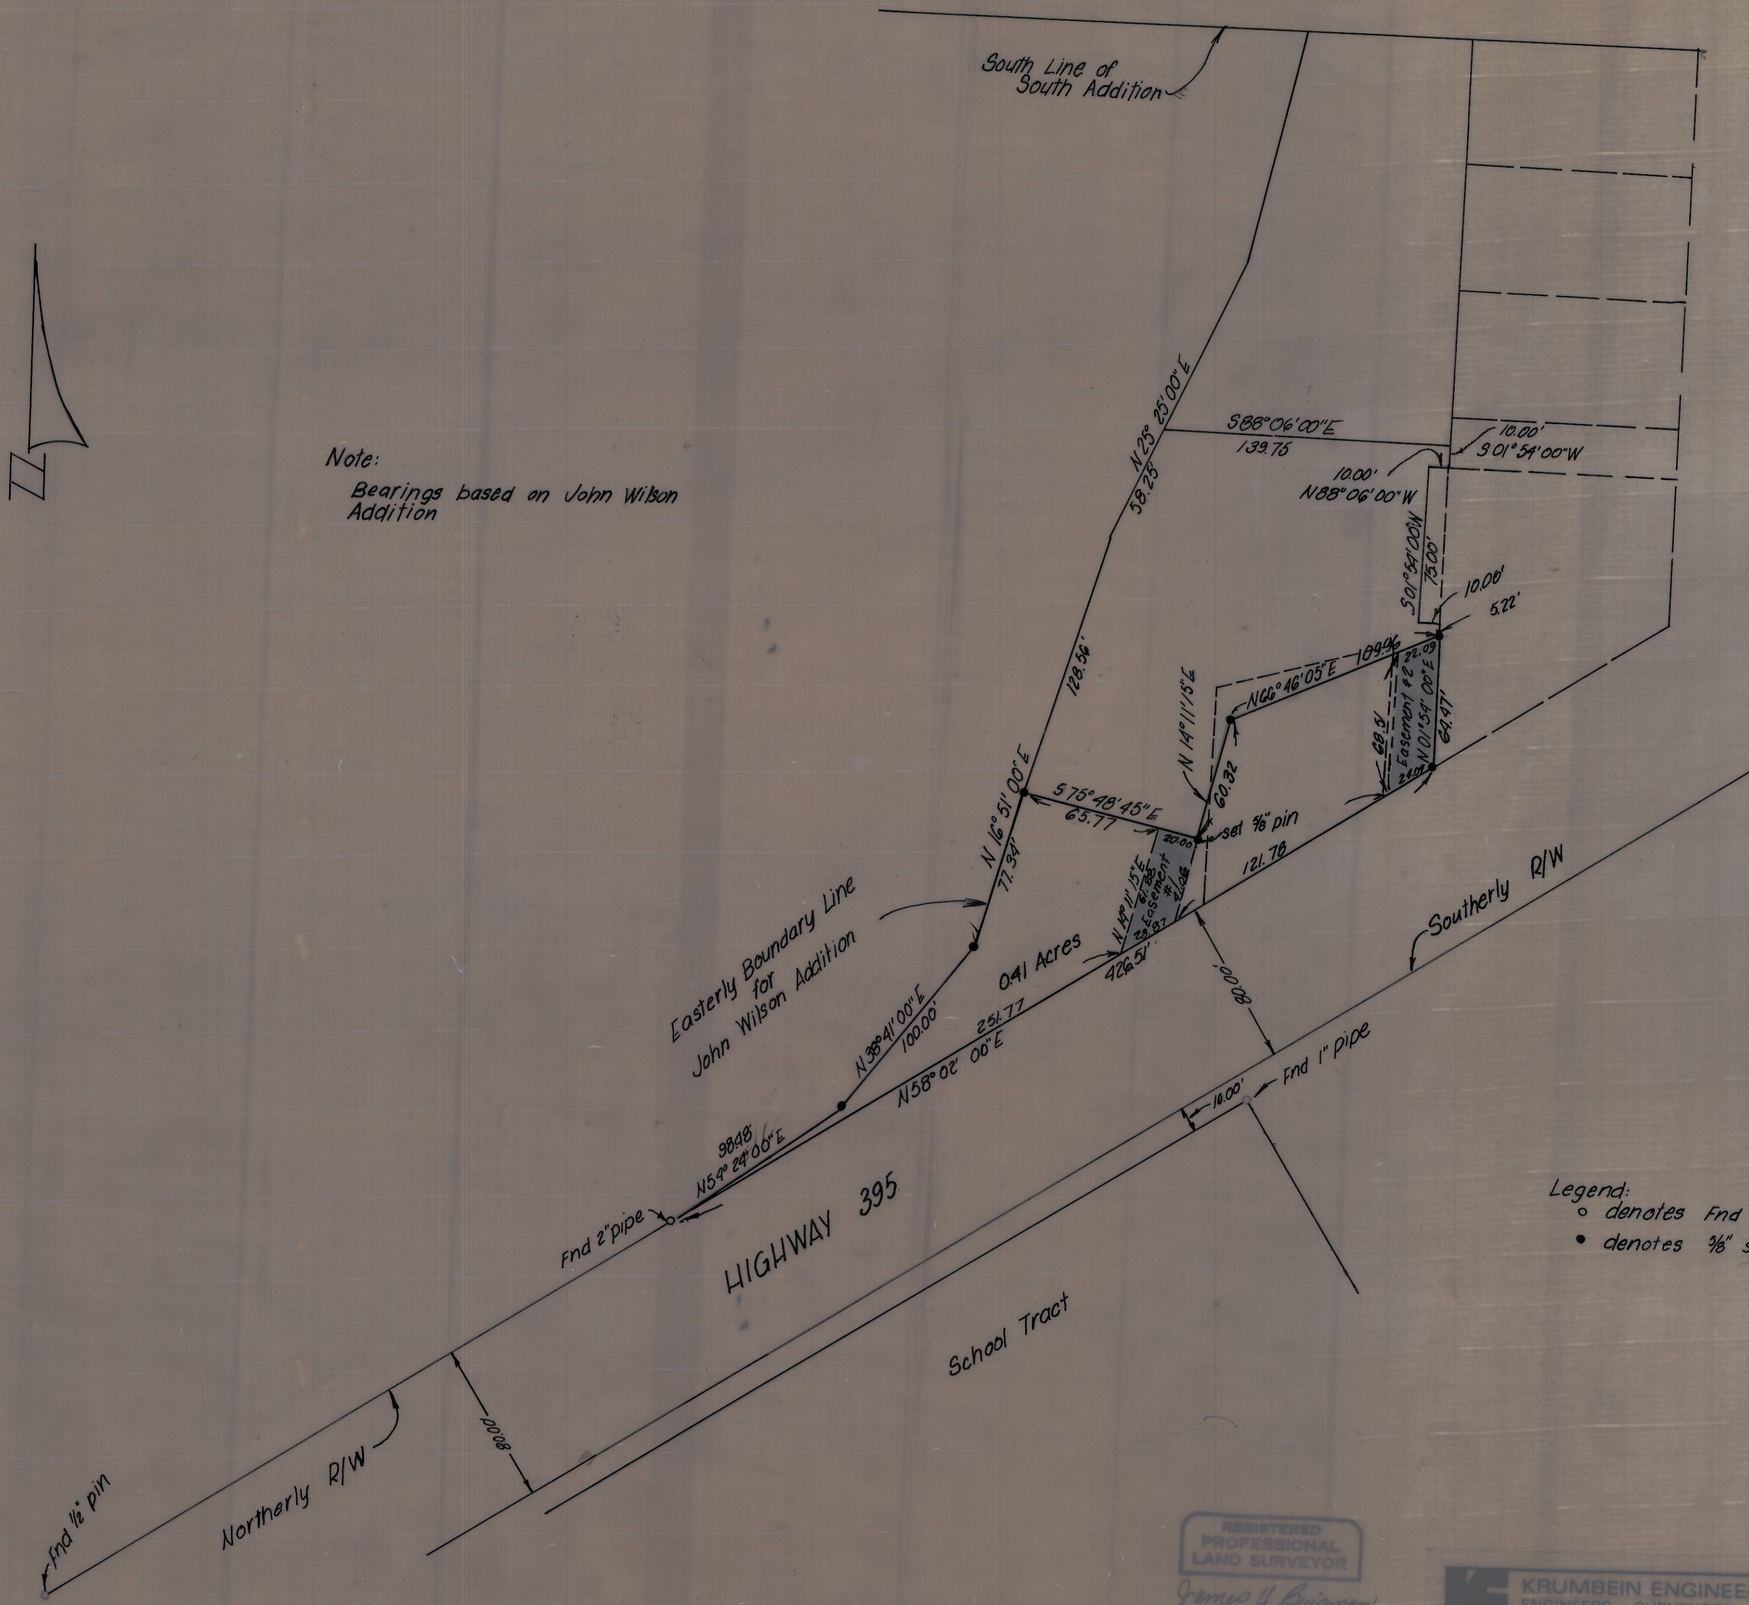

Legend:
- ○ denotes Fnd
- ● denotes 3/8" set pin

REGISTERED PROFESSIONAL LAND SURVEYOR
James H. Buisman
OREGON
JULY 22, 1977
JAMES H. BUISMAN
1097

KRUMBEIN ENGINEERING CO
ENGINEERS – SURVEYORS – PLANNERS
221 S. Main, Pendleton, Oregon

Survey for
JACK STURTEVANT
desc. parcel in NE 1/4, SE 1/4 Sec 17, T 1S, R 32 E

SCALE	1" = 50'
DATE	Mar. 13, 1978
SURVEY BY	TAG
CO. BY	TEH
DRWG. NO	78-23C

O-13

B

Job No. 78-21