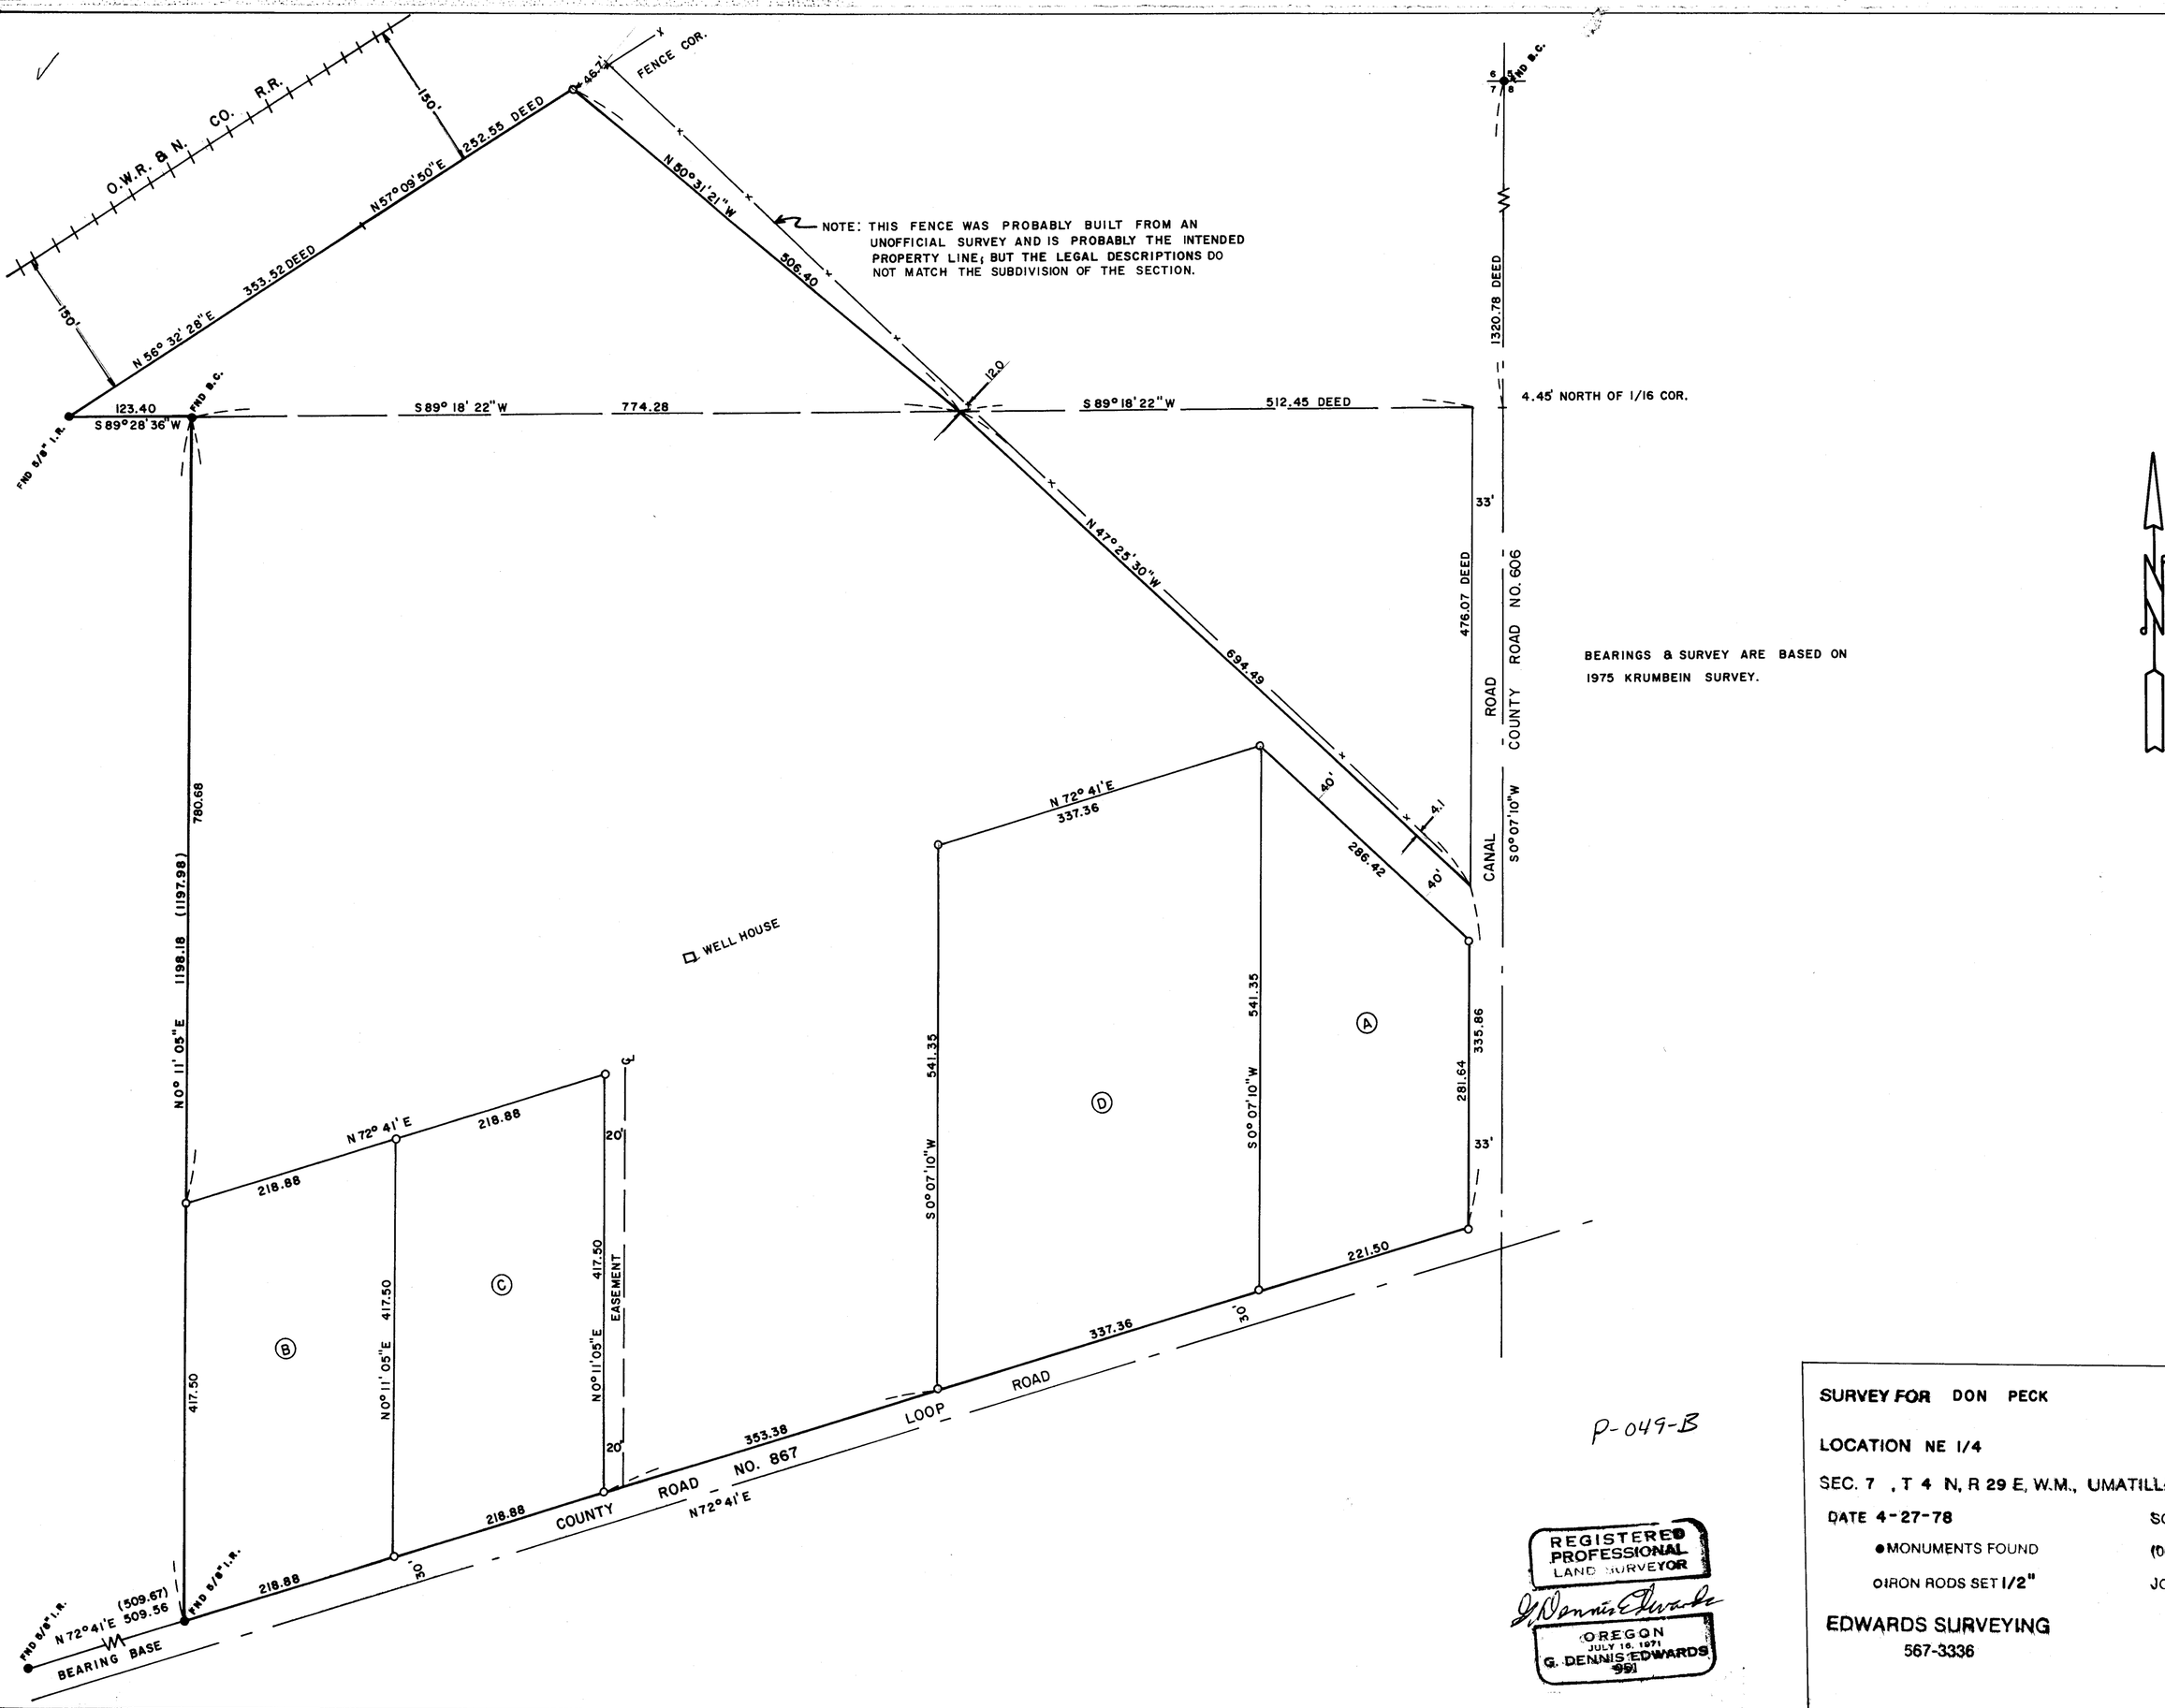

BEARINGS & SURVEY ARE BASED ON 1975 KRUMBEIN SURVEY.

P-049-B

REGISTERED PROFESSIONAL LAND SURVEYOR
G. Dennis Edwards
OREGON JULY 16, 1971
G. DENNIS EDWARDS 991

SURVEY FOR DON PECK

LOCATION NE 1/4

SEC. 7 , T 4 N, R 29 E, W.M., UMATILLA COUNTY, OREGON

DATE 4-27-78 SCALE: 1" = 100'

● MONUMENTS FOUND (000) OF RECORD

○ IRON RODS SET 1/2" JOB NO. S7804146

EDWARDS SURVEYING P. O. Box 763

567-3336 Hermiston, Ore.