
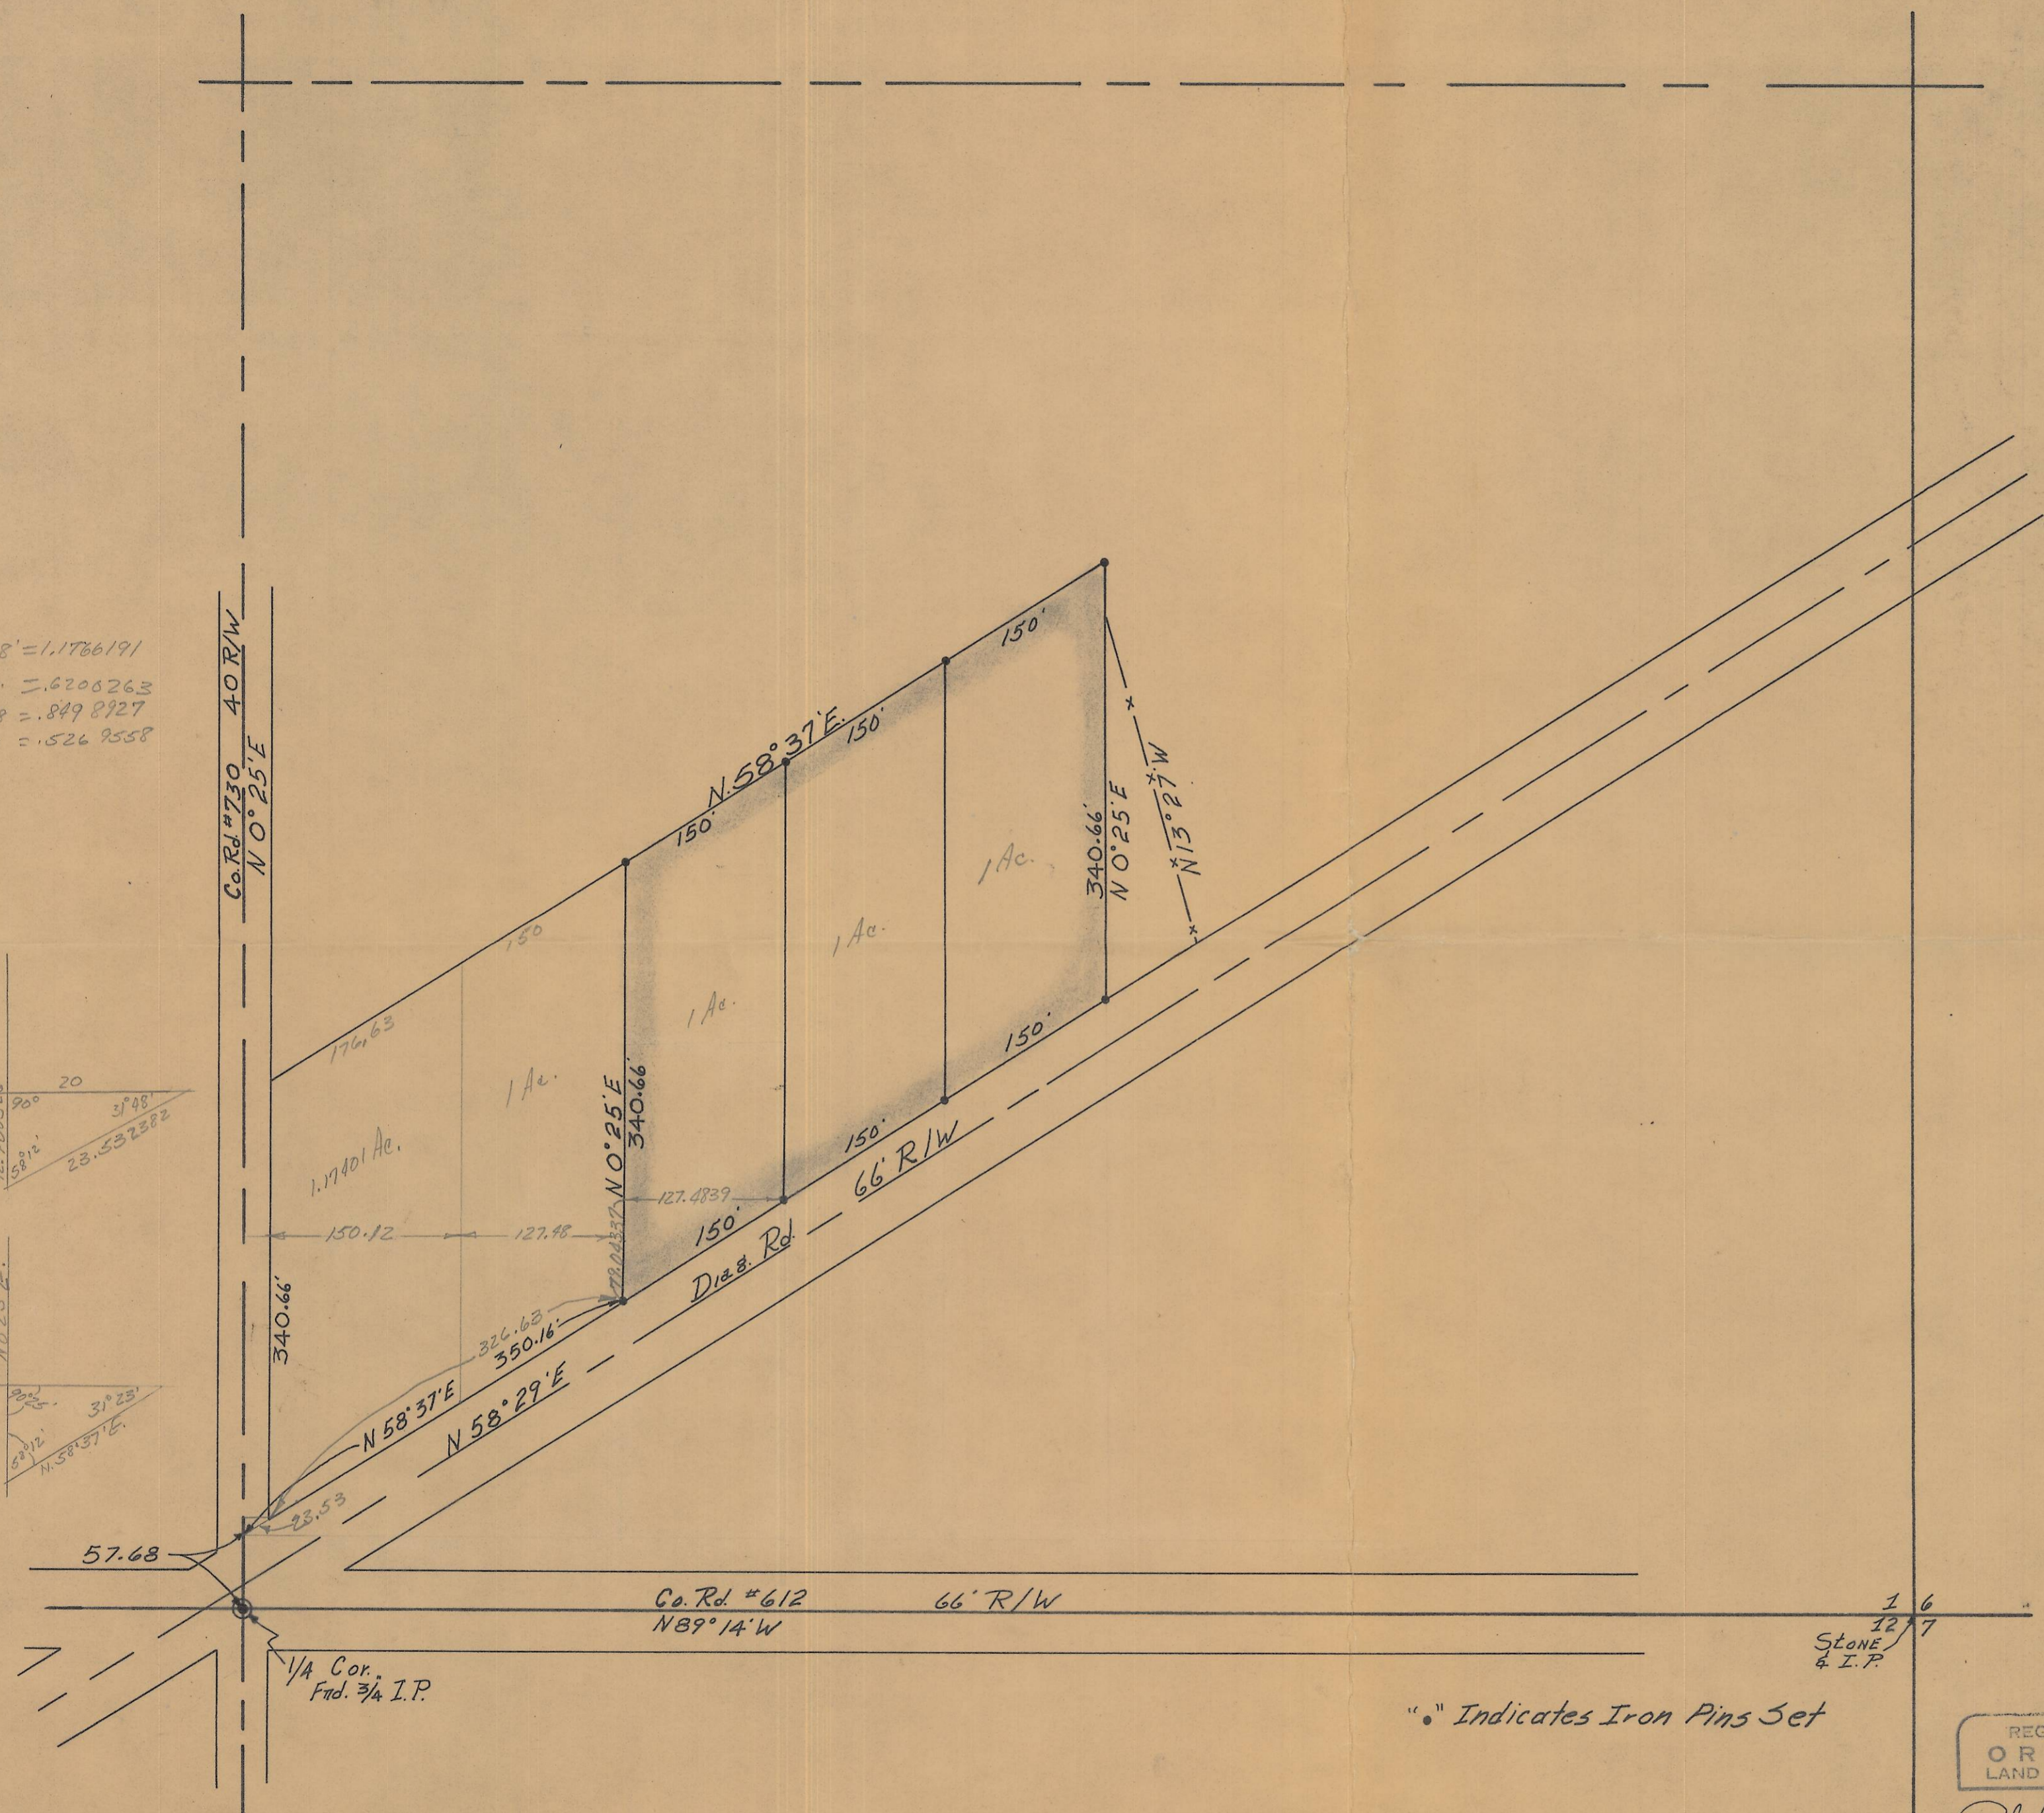


Sec. $21^{\circ}48' = 1.1766191$
 Tan. " " = 0.206263
 Cot. $31^{\circ}48' = 1.8498927$
 Sin. " " = 0.5269558

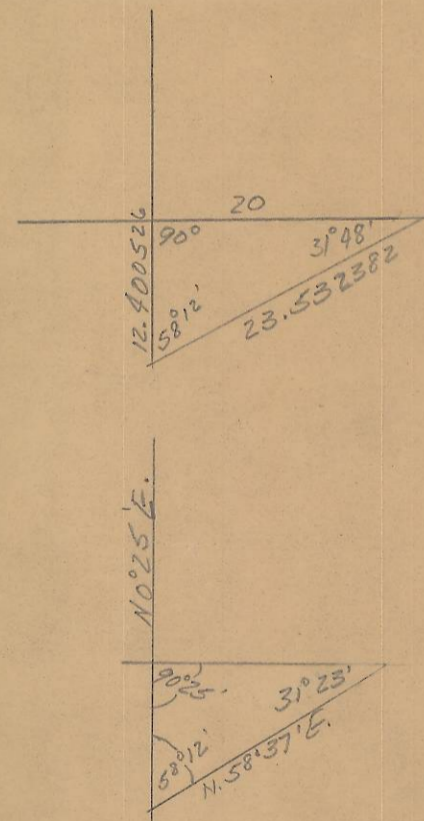

"." Indicates Iron Pins Set

REGISTERED
 OREGON
 LAND SURVEYOR
Ralph P. Thompson
 MAY 13, 1950
 RALPH P. THOMPSON
 508

Property Survey For
HENRY MIKKELSON
 SE 4 Sec. 1 T. 4 N. R. 28 E. W.M.
 Date: 17 May 1962 Scale: 1" = 100'
 Ralph P. Thompson
 Land surveying
 Pendleton, Ore.

Q-552-B
 JUN 28 1962