


2650.64
1325.54
1325.10

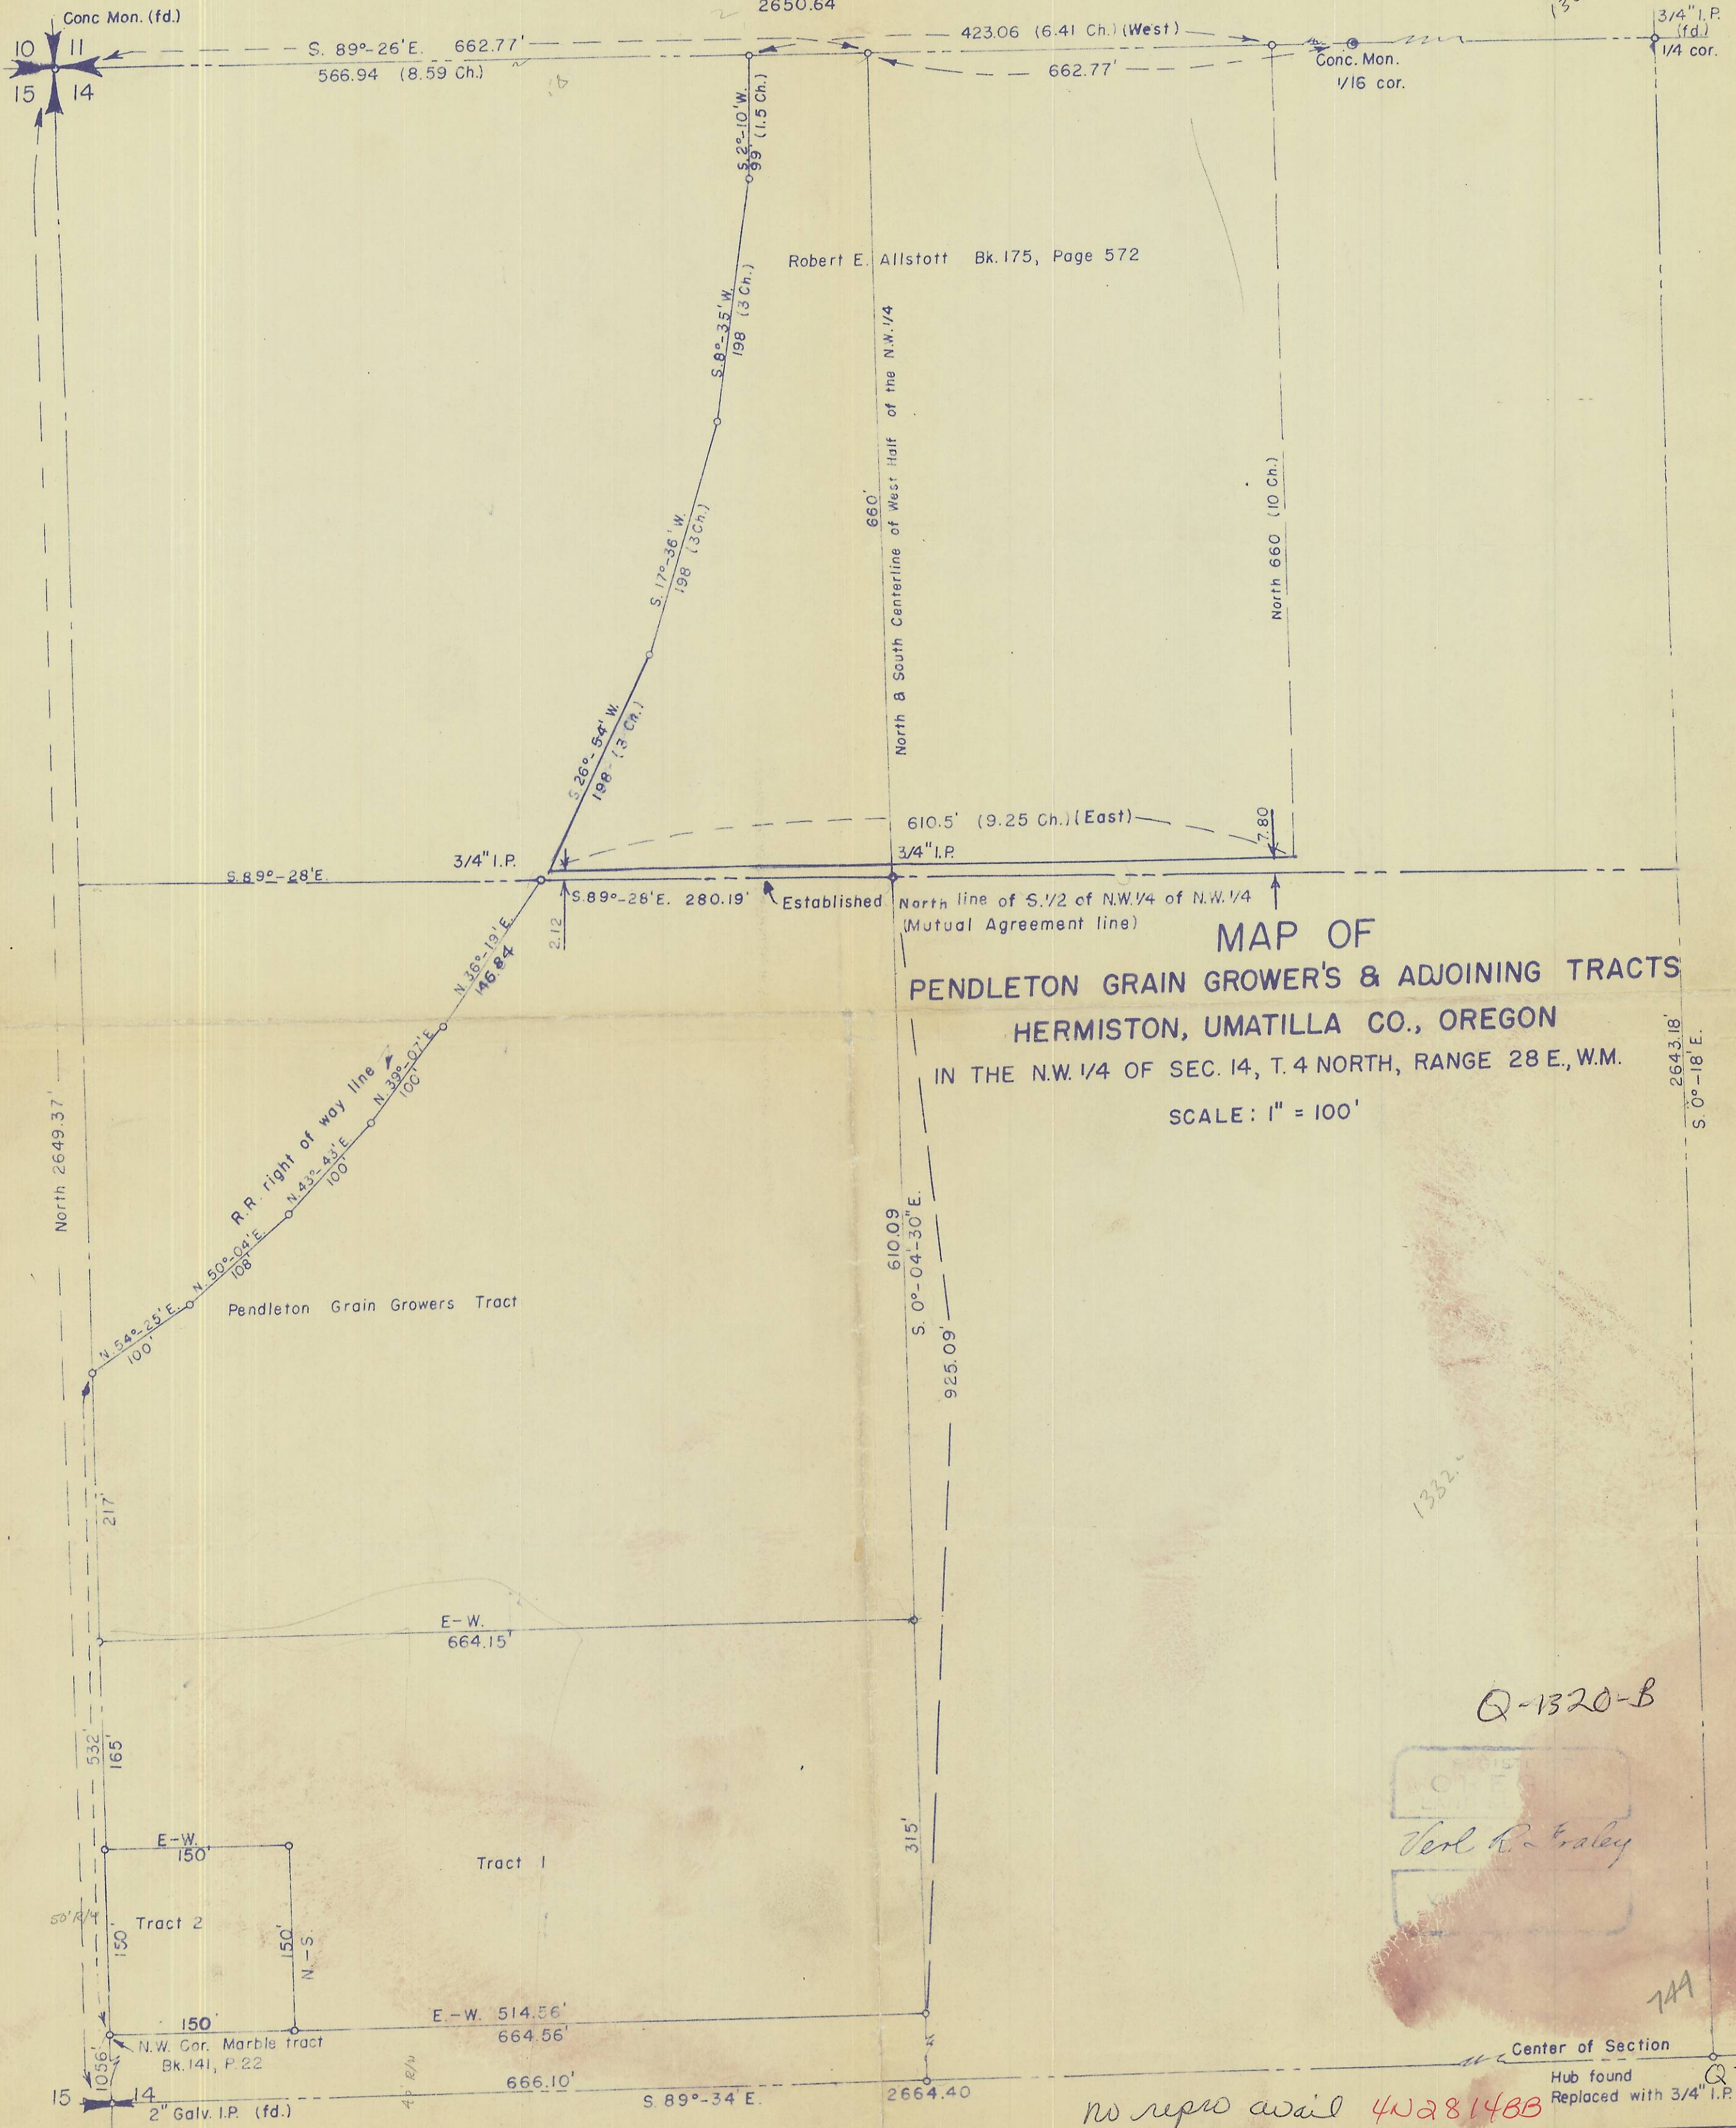

**MAP OF
PENDLETON GRAIN GROWER'S & ADJOINING TRACTS
HERMISTON, UMATILLA CO., OREGON
IN THE N.W. 1/4 OF SEC. 14, T. 4 NORTH, RANGE 28 E., W.M.
SCALE: 1" = 100'**

744

1322

Q-1320-B

Verl R. Gray

Center of Section
Hub found
Replaced with 3/4" I.P.

no repro avail 40281488

Q-1320-B