


NOTE
 Monument boxes in Main Street were set by the Umatilla County Surveyor, dated December 28, 1978, Umatilla County Survey Records drawing no. Q-1122-C.
 Set buildings one foot higher than the intersection of Center and Madison streets.

- denotes monument found as noted
- denotes 1/2 in. x 24 in. iron pin set
- denotes P.K. nail set

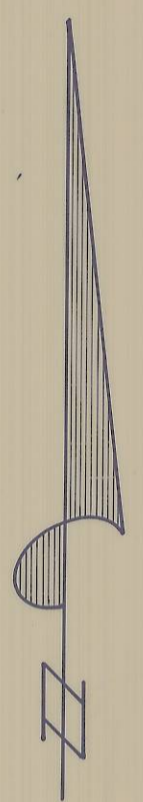

REGISTERED
 PROFESSIONAL
 LAND SURVEYOR
 David H. Klein

RECEIVED BY
 Umatilla County Surveyor
 Date 2-2-81
 Rec'd By BLS
 No. S-41-B

<p>KRUMBEIN ENGINEERING CO. ENGINEERS - SURVEYORS - PLANNERS 221 S. Main, Pendleton, Oregon</p>	SCALE 1" = 30'
	DATE April 7, 1981
	DRN BY MA
	CKD BY DAK
	DRNG NO 81-18C

Survey for
HGM
 Lots 1, 2, 3, & 12, Block 7, Original Town of Adams, Oregon