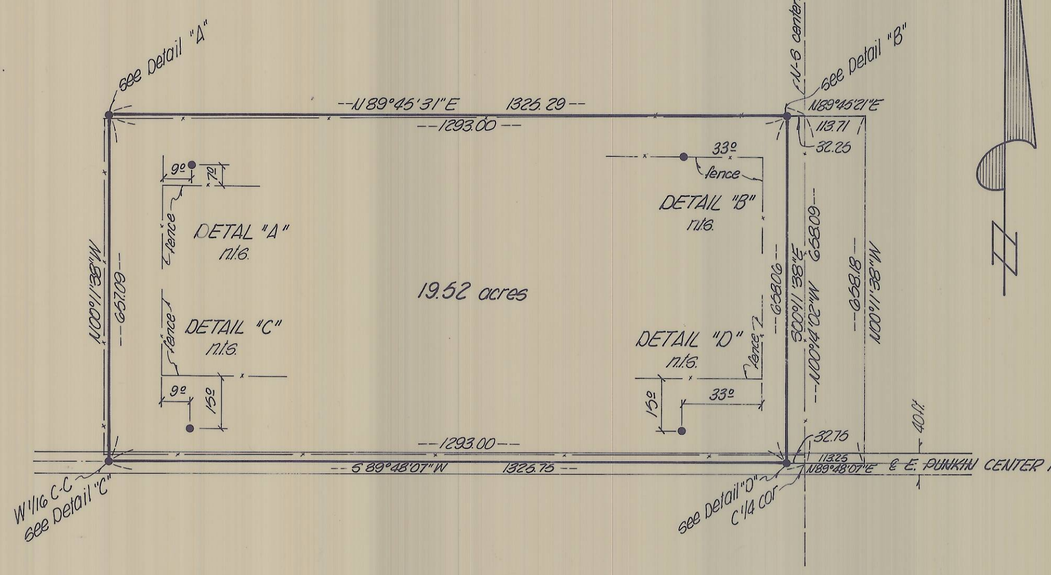

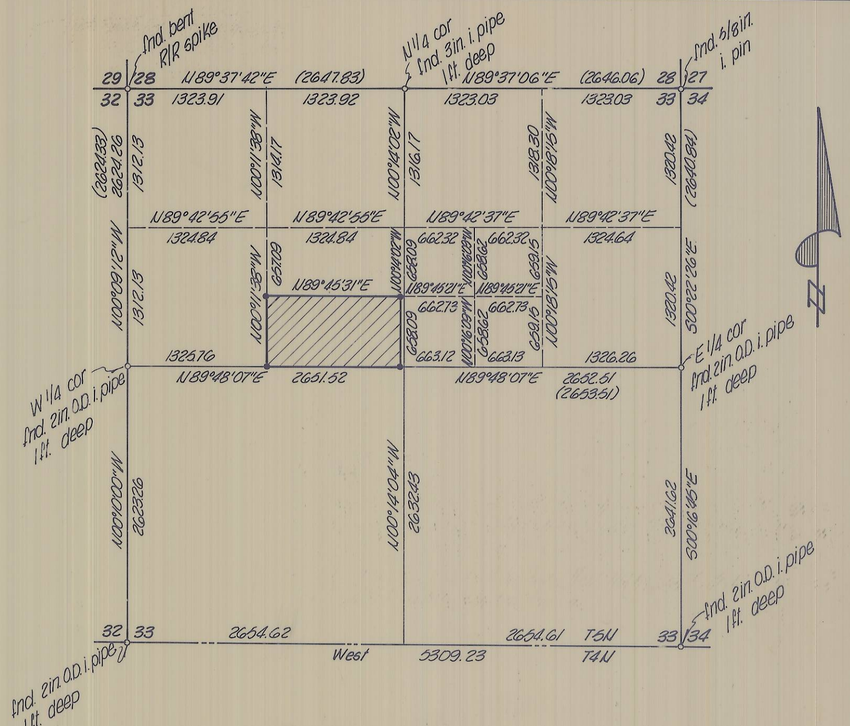

SECTION 33, T5N, R29E, W.M.

1" = 1000'

- ○ denotes monument found as noted
- ● denotes 1/2 in. iron pin set
- ( ) denotes distance of record

NOTE

Bearings and section breakdown are based on a survey by Donald L. Stoebler for Hermiston Realty, dated December 3, 1975, Umatilla County Survey Records drawing no. K-7-B.

REGISTERED PROFESSIONAL LAND SURVEYOR
OREGON
JULY 14, 1978
TERRY E. HAMBY
1638

RECEIVED BY
Umatilla County Surveyor
Date 4-81
Rec'd by
No. BLS S-42-B

KRUMBEIN ENGINEERING CO.
ENGINEERS – SURVEYORS – PLANNERS
221 S. Main, Pendleton, Oregon

Survey for
JIM GODIER

located in the SE¼, NW¼, Section 33, T5N, R29E, W.M.

SCALE	1" = 200'
DATE	April 7, 1981
DRN. BY	MA
CKD BY	T.E.H.
DRNG. NO.	81-17C

Job No. 81-39