


#	Slope	Dist	Corr Dist	Vert X
1	501.24	496.13	98°43'10"	
2	889.25	786.01	94°53'35"	
3	1163.58	1161.16	93°41'50"	
4	1348.25	1346.52	92°59'15"	
5	1155.16	1152.72	93°34'00"	

SUNSET VALLEY TRACTS Block 3

2 41 25	12 41 45	12 41 45
96 30 38	88 10 49	88 34 30
99 12 23	100 52 34	101 18 15
192 41 45	142 41 45	142 41 45
67 21 15	58 34 40	51 34 02
125 20 30	134 07 05	141 05 43

SCALE: 1" = 100'
 DATE: 6-25-73
 Rev: 7-3-73
 8-29-73
 9-19-73

Set Stake at Intersection of Fences

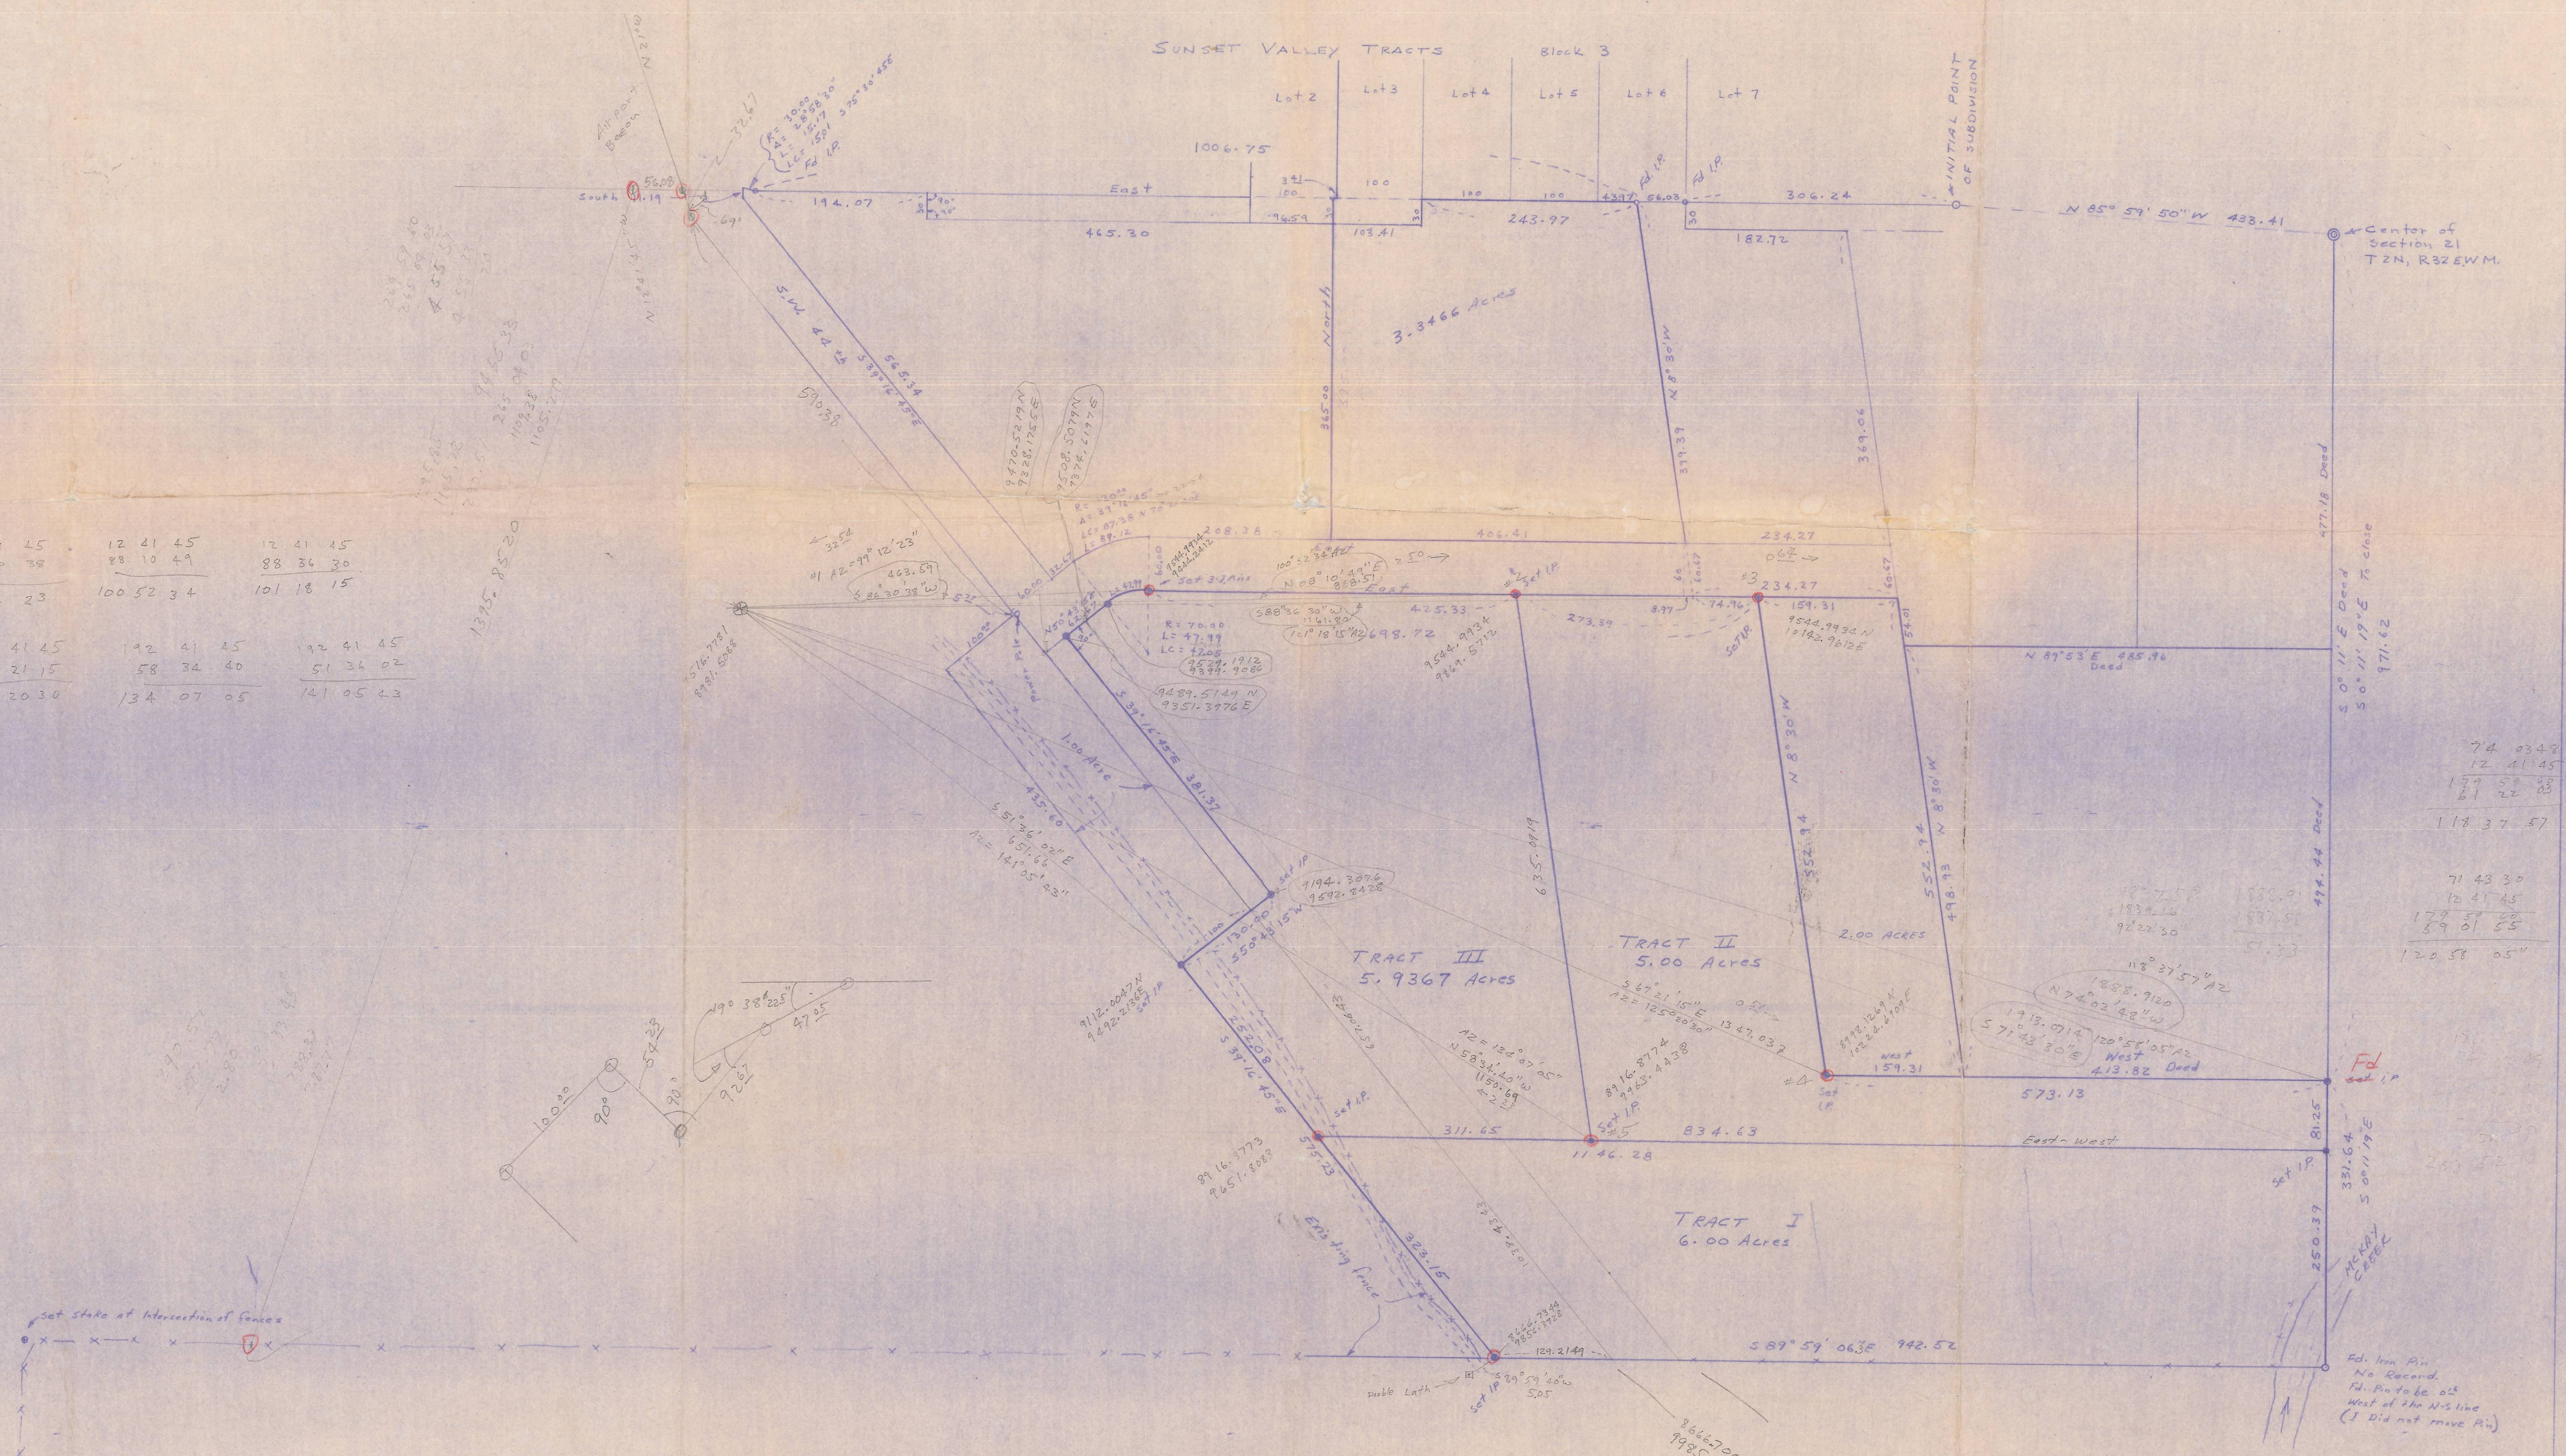

04-232-C
 LAND SURVEY FOR
 ED LORREN, LAWRENCE OLSON &
 ART MARSH ALL IN THE
 SW 1/4 OF SECTION 21, T2N, R32E
 PENDLETON, OREGON
 SCALE 1" = 100' DATE: 6-25-73 Revised 9-19-73
 Rev: 7-3-73
 DONALD L. STABLER
 CONSULTING ENGINEER
 P.O. BOX 91
 PENDLETON, OREGON