

- LEGEND:**
- MONUMENT FOUND AS NOTED
 - SET 5/8"X30" IRON REBAR WITH PLASTIC CAP #951
 - ⊙ COMPUTED LOCATION
 - [000] OF RECORD, 1950 FRALEY SURVEY
 - [000] OF RECORD, MY 1975 SURVEY FOR CAPPER

NARRATIVE:


THE PURPOSE OF THIS SURVEY IS TO STAKE THOSE TRACTS OF LAND DEEDED TO GLENN AND ERIN CHOWNING ON REEL 185, PAGE 1056, AND TO CHOWNING LAND, LLC, ON REEL 364, PAGE 382, UMATILLA COUNTY DEED RECORDS TO SEE HOW FENCES LIE AND SO IMPROVEMENTS INCLUDING IRRIGATION PIPE LINES CAN BE TIED.

I BASED THIS SURVEY ON ONE DONE BY ME IN THE SOUTH HALF OF SECTION 9 FOR CAPPER IN 1975 WHICH WAS BASED ON ONE DONE BY FRALEY IN 1950. BEARINGS ARE TRUE BASED ON MY 2004 G.I.S. SURVEY FOR UMATILLA COUNTY IN THE CITY OF HERMISTON.

REGISTERED
PROFESSIONAL
LAND SURVEYOR

G. Dennis Edwards

OREGON
JULY 16, 1971
G. DENNIS EDWARDS
9 5 1
RENEWS 12/31/2005

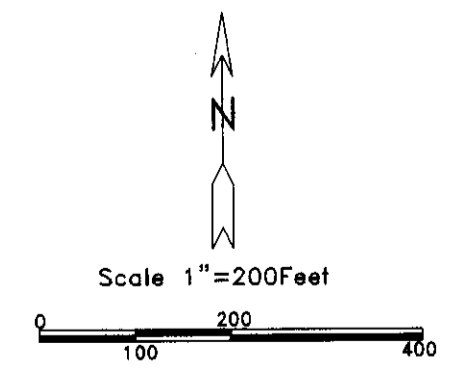

SURVEY FOR GLENN CHOWNING
IN S 1/2, SEC. 9, T 4 N, R 28 E,
W.M., UMATILLA COUNTY, OREGON
6/27/2005 JOB# S0506093
EDWARDS SURVEYING P.O. BOX 763
541-567-3336 HERMISTON, OREGON 97838
DRAWN BY NJF

RECEIVED BY
Umatilla County Surveyors
Date: 7-05
Rec'd by: KK
No. 05-MPC