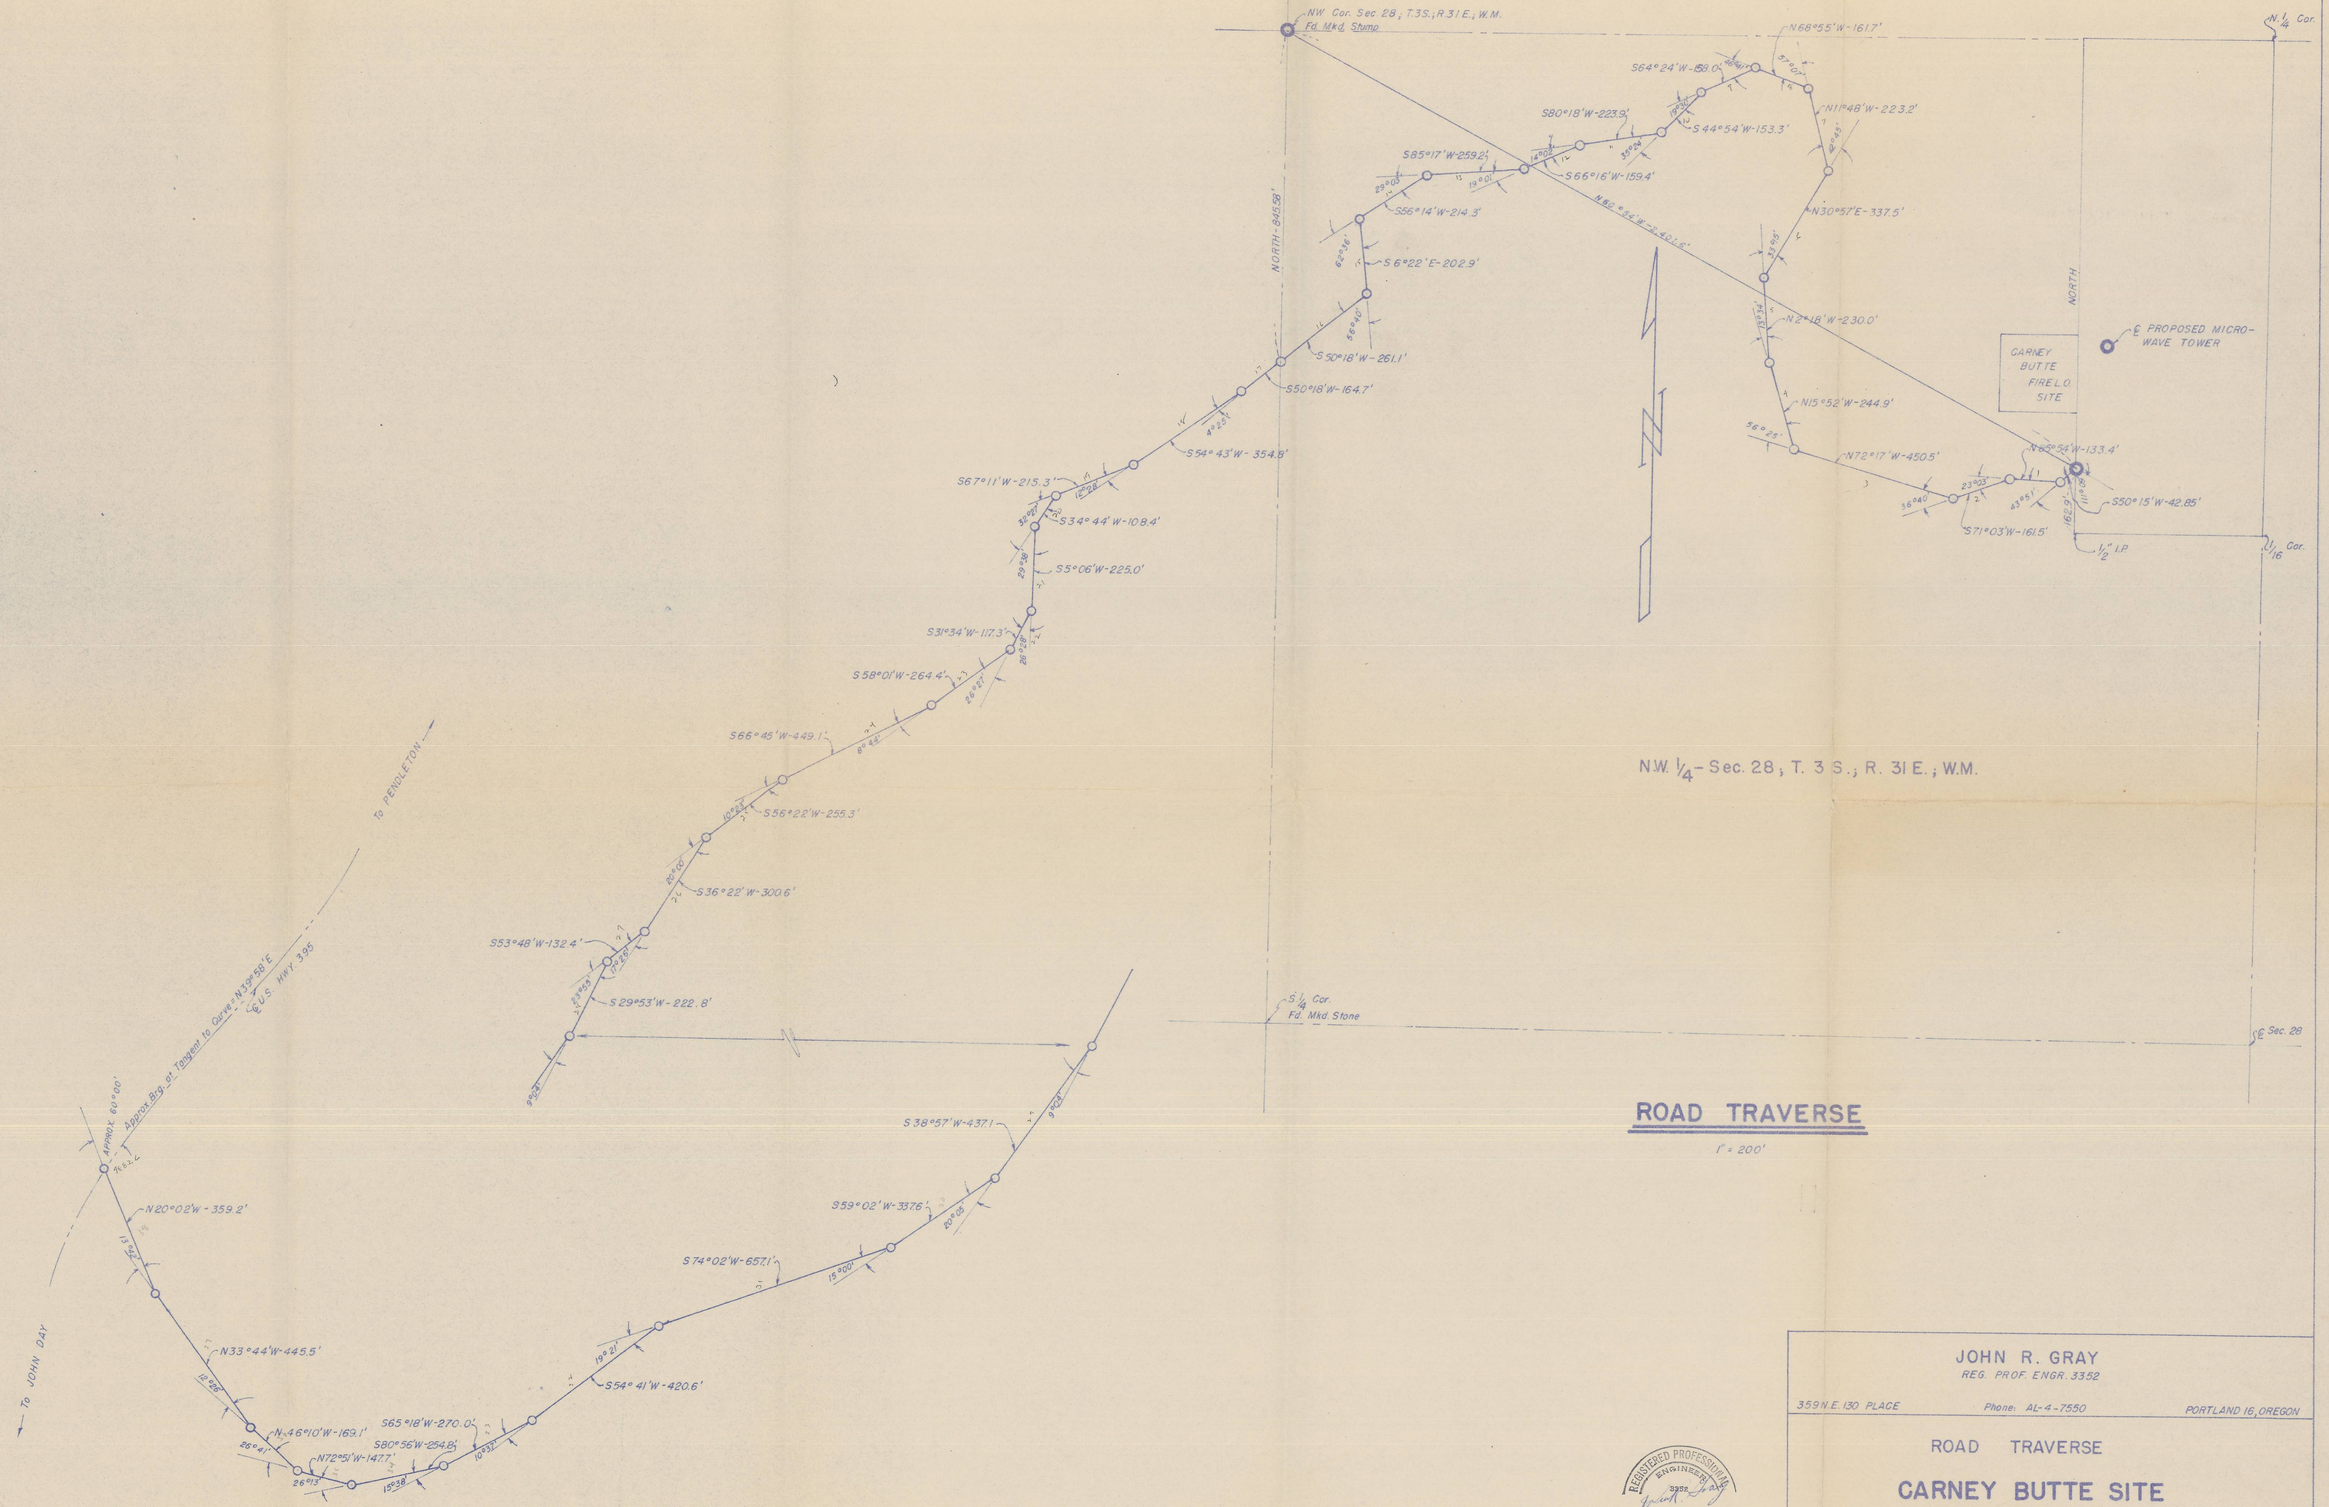

ROAD TRAVERSE

1" = 200'

JOHN R. GRAY
REG. PROF. ENGR. 3352
359 N.E. 130 PLACE Phone: AL-4-7550 PORTLAND 16, OREGON

REGISTERED PROFESSIONAL ENGINEER 3352 OREGON NOV. 3, 1959 JOHN R. GRAY

ROAD TRAVERSE

CARNEY BUTTE SITE

UMATILLA COUNTY, OREGON

DRAWN BY: JRG	DEC. 9, 1956	SHEET 1 OF 1
CHECKED BY: JRG	JOB 56-58	

06-594-C