


VICINITY MAP

SCALE 1"=400'

PLAN A

SCALE 1"=100'

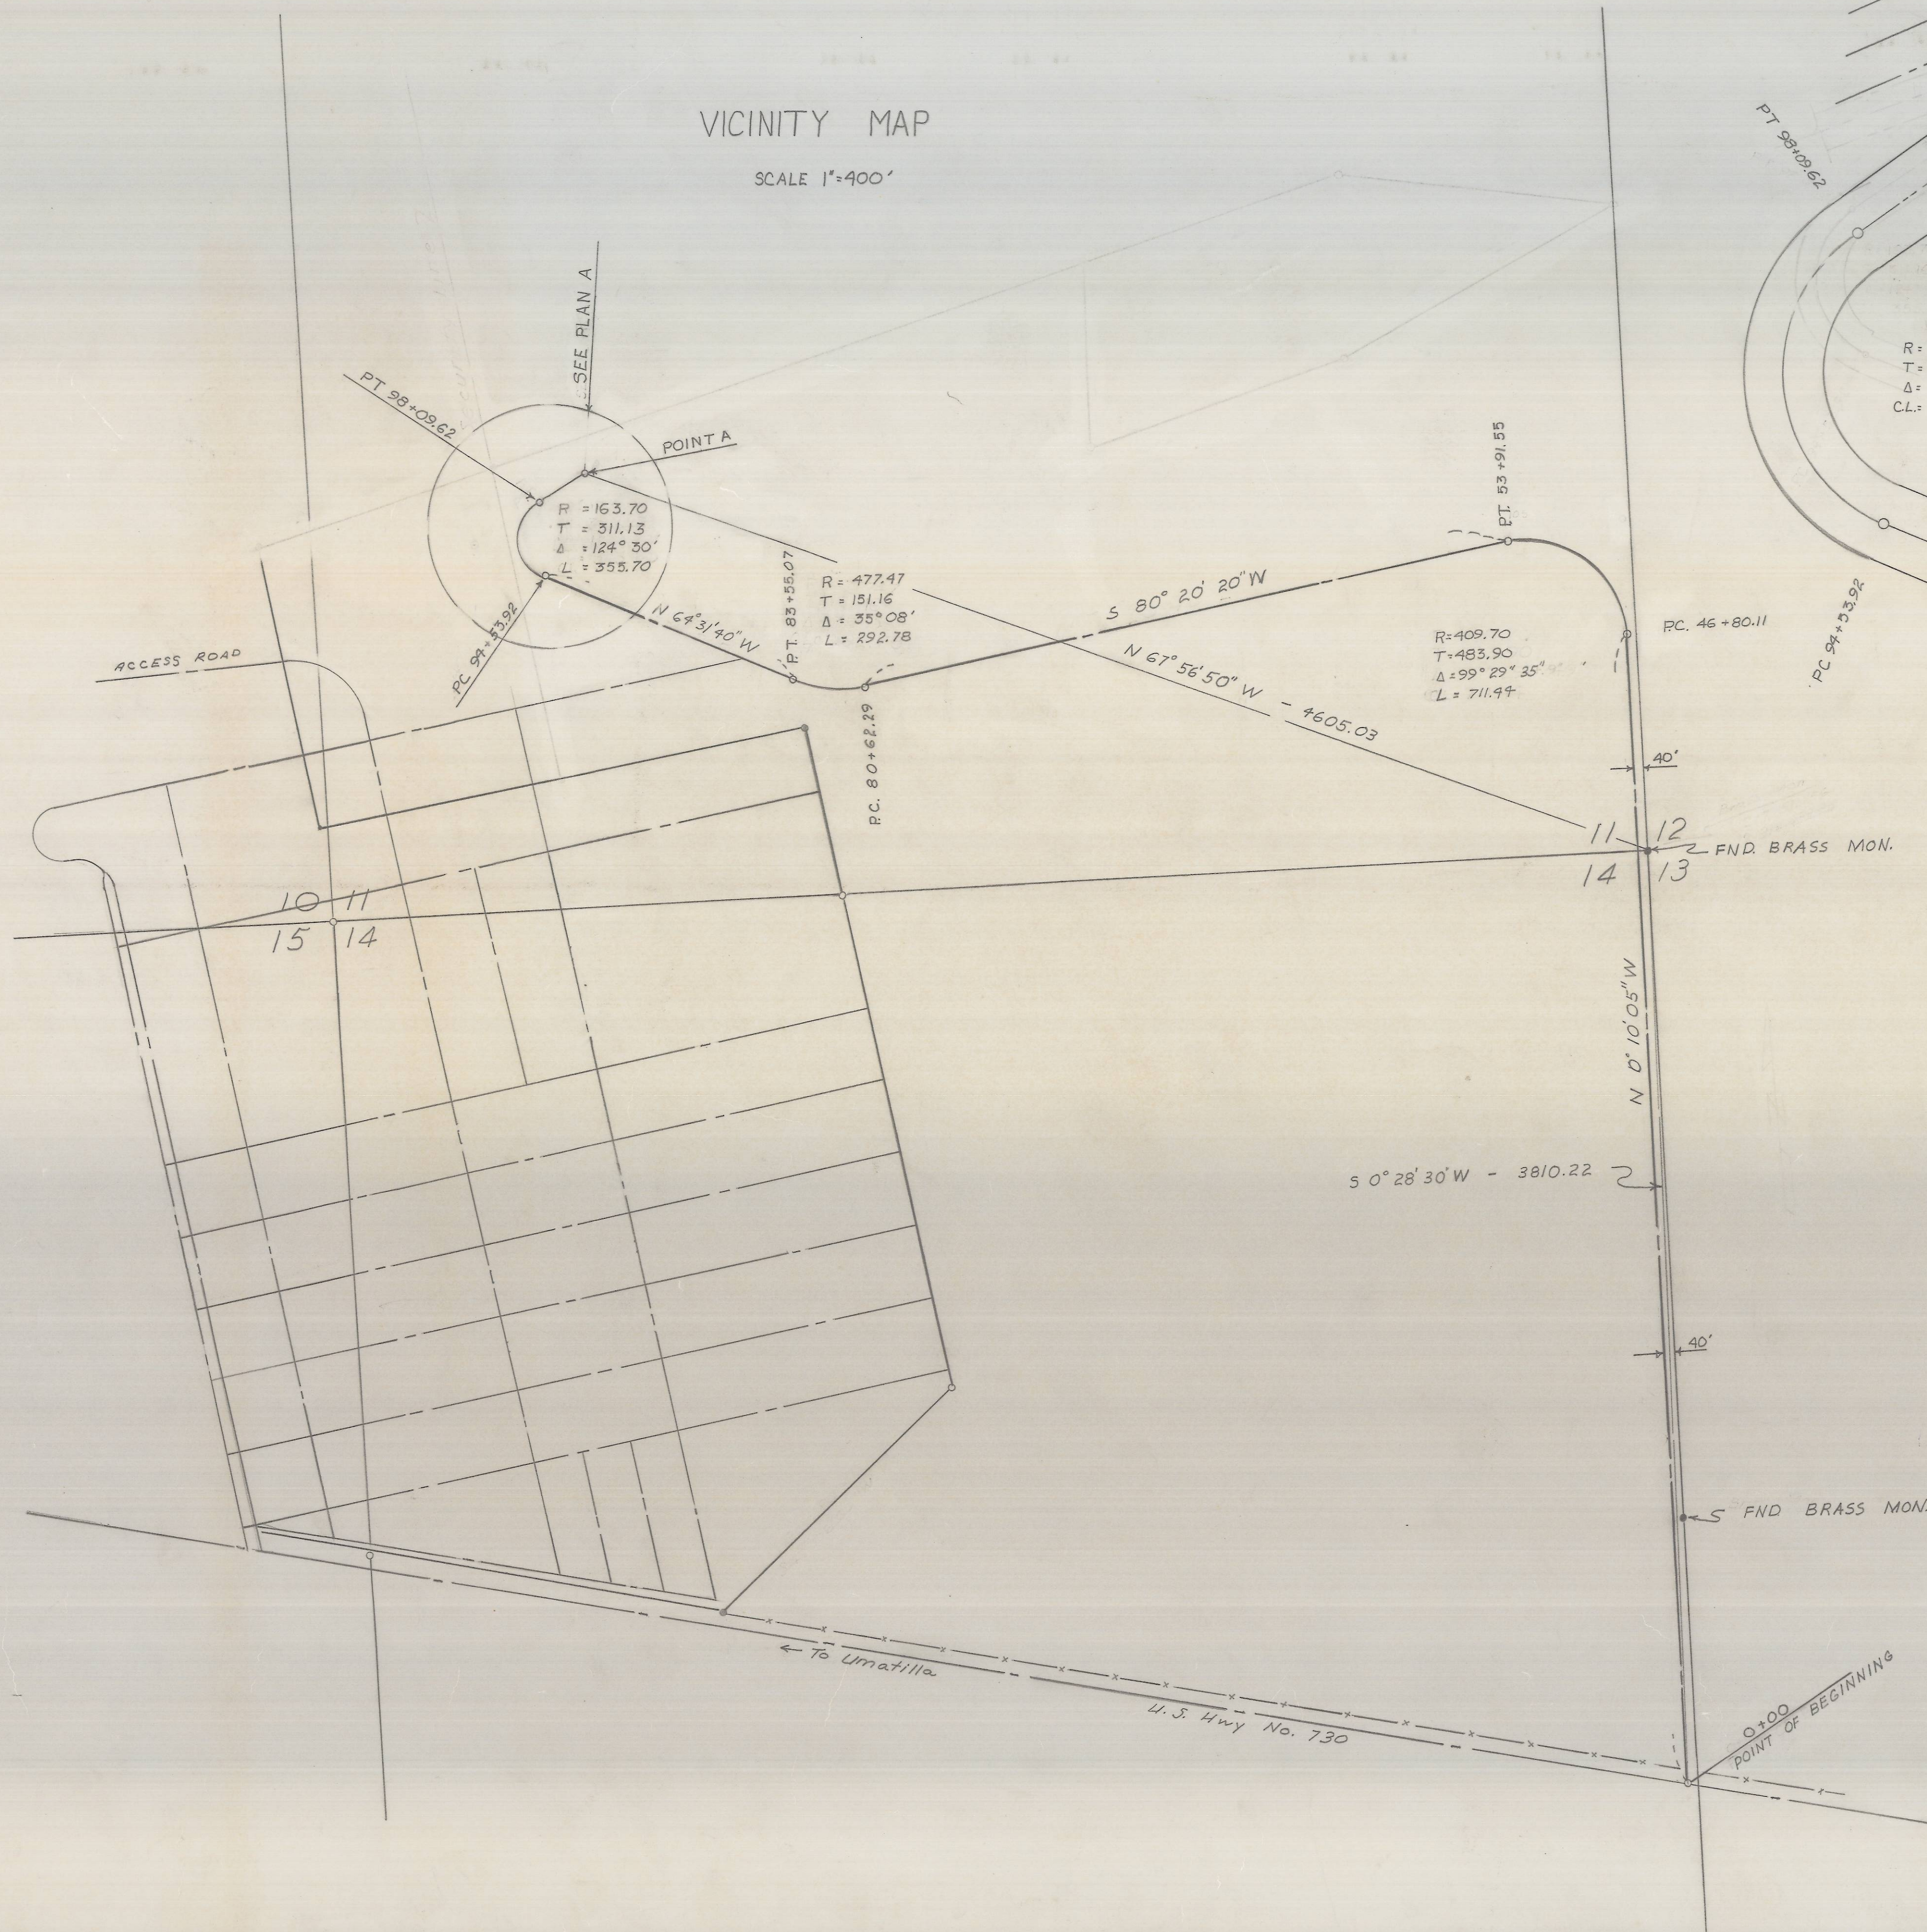

NOTE:
 BEARINGS ARE BASED UPON TIES
 TO N.O.S. STATIONS "CINCO", "VACA",
 AND "WHITEY". THOSE SHOWN
 ARE TRUE. $\theta = +0^\circ 51' 25"$
 SEA LEVEL GRID FACTOR = 9999560

REGISTERED
 PROFESSIONAL
 LAND SURVEYOR
 David H. Krumben
 OREGON
 JULY 17, 1979
 DAVID H. KRUMBEIN
 933

W-213-C
 WAYNE HARRIS CO., INC.

SURVEY FOR
 COUNTY ROAD DEPARTMENT
 PORT OF UMATILLA ROAD
 SEC. 11 & 14, T5N, R28E, W.M.

SCALE	DATE	DRN BY	DRNG NO
A3 SHOWN	12 / 4 / 72	TH	72-318-C