


INSERT
SCALE: 1" = 20'

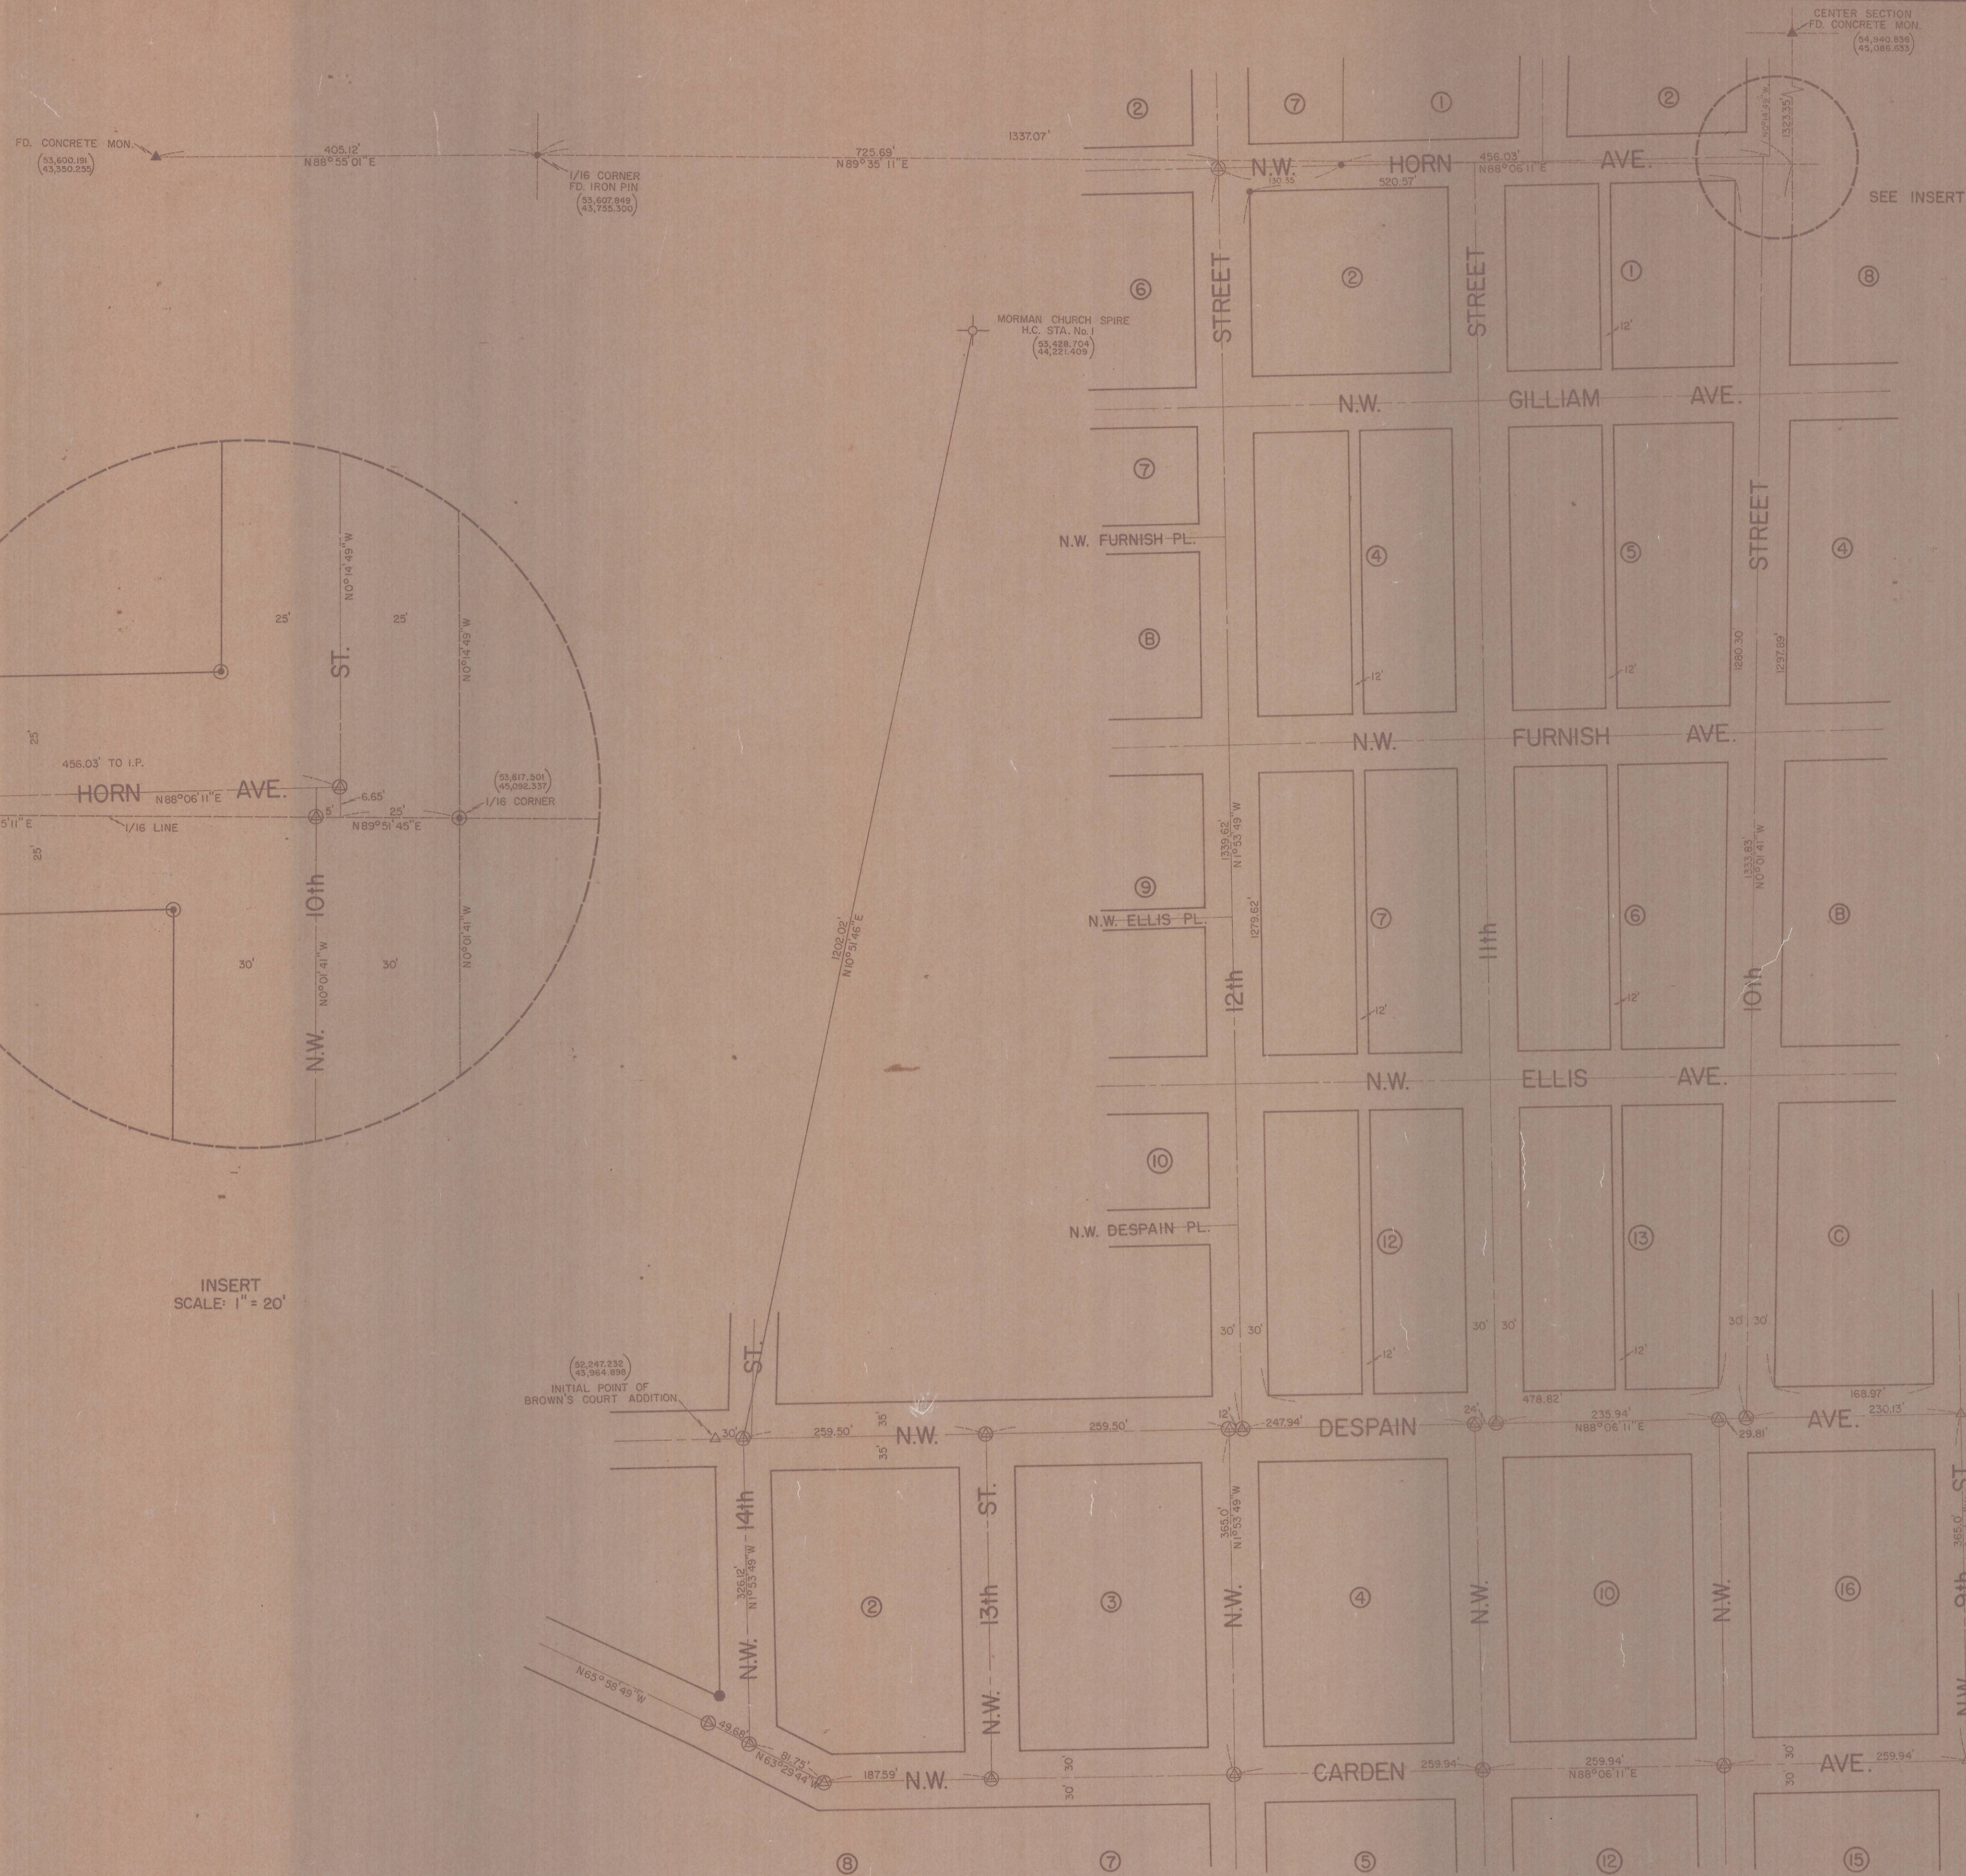

NOTES:

MONUMENTS SET ARE FROM AN ADJUSTED BALANCED CONTROL NET AND BASED UPON ORIGINAL FOUND MONUMENTS TO THE NORTH AND ON DESPAIN AVE.
ALL BEARINGS SHOWN ARE BASED ON THE PENDLETON LOCAL GRID.

LEGEND

- - STONE
- - VALVE BOX
- - BRASS CAP
- ▲ - RR SPIKE
- ▲ - BOLT
- - IRON PIPE
- - IRON PIN
- - CIRCLED MONUMENTS SET PER THIS SURVEY



L 26-c

CITY OF PENDLETON
ENGINEERING DEPT.

**CONTROL SURVEY
N.W. CARDEN R/W**

| | | |
|----------------|------------------|--------------|
| DATE: MAY 1976 | SCALE: 1" = 100' | SHEET 2 OF 2 |
| DN: RB | CHD: 910 | DWG. NO. |

24-7723