


Invert 74.53
Rim 78.97

Rim 79.23
Invert 71.41

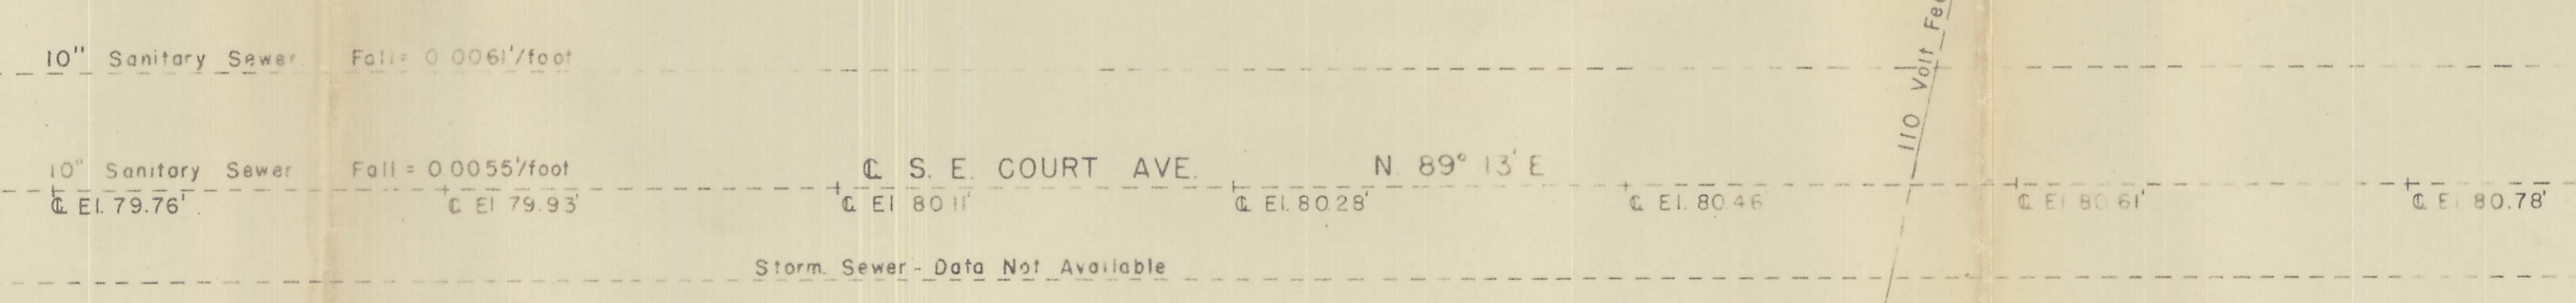

NOTE
Datum is U.S.G.S. Add 1000' to Elevations.



72UR32 2 CD

HAYES & HARRIS ENGINEERING

SURVEY FOR
UNION OIL COMPANY
OF LOTS 6 & 7, BLOCK 6, JACOBS ADD'N
PENDLETON, OREGON

SCALE 1" = 8'	DATE 12-12-54	DRAWN BY W.O.H. 315
------------------	------------------	------------------------

Q-348-C 015