




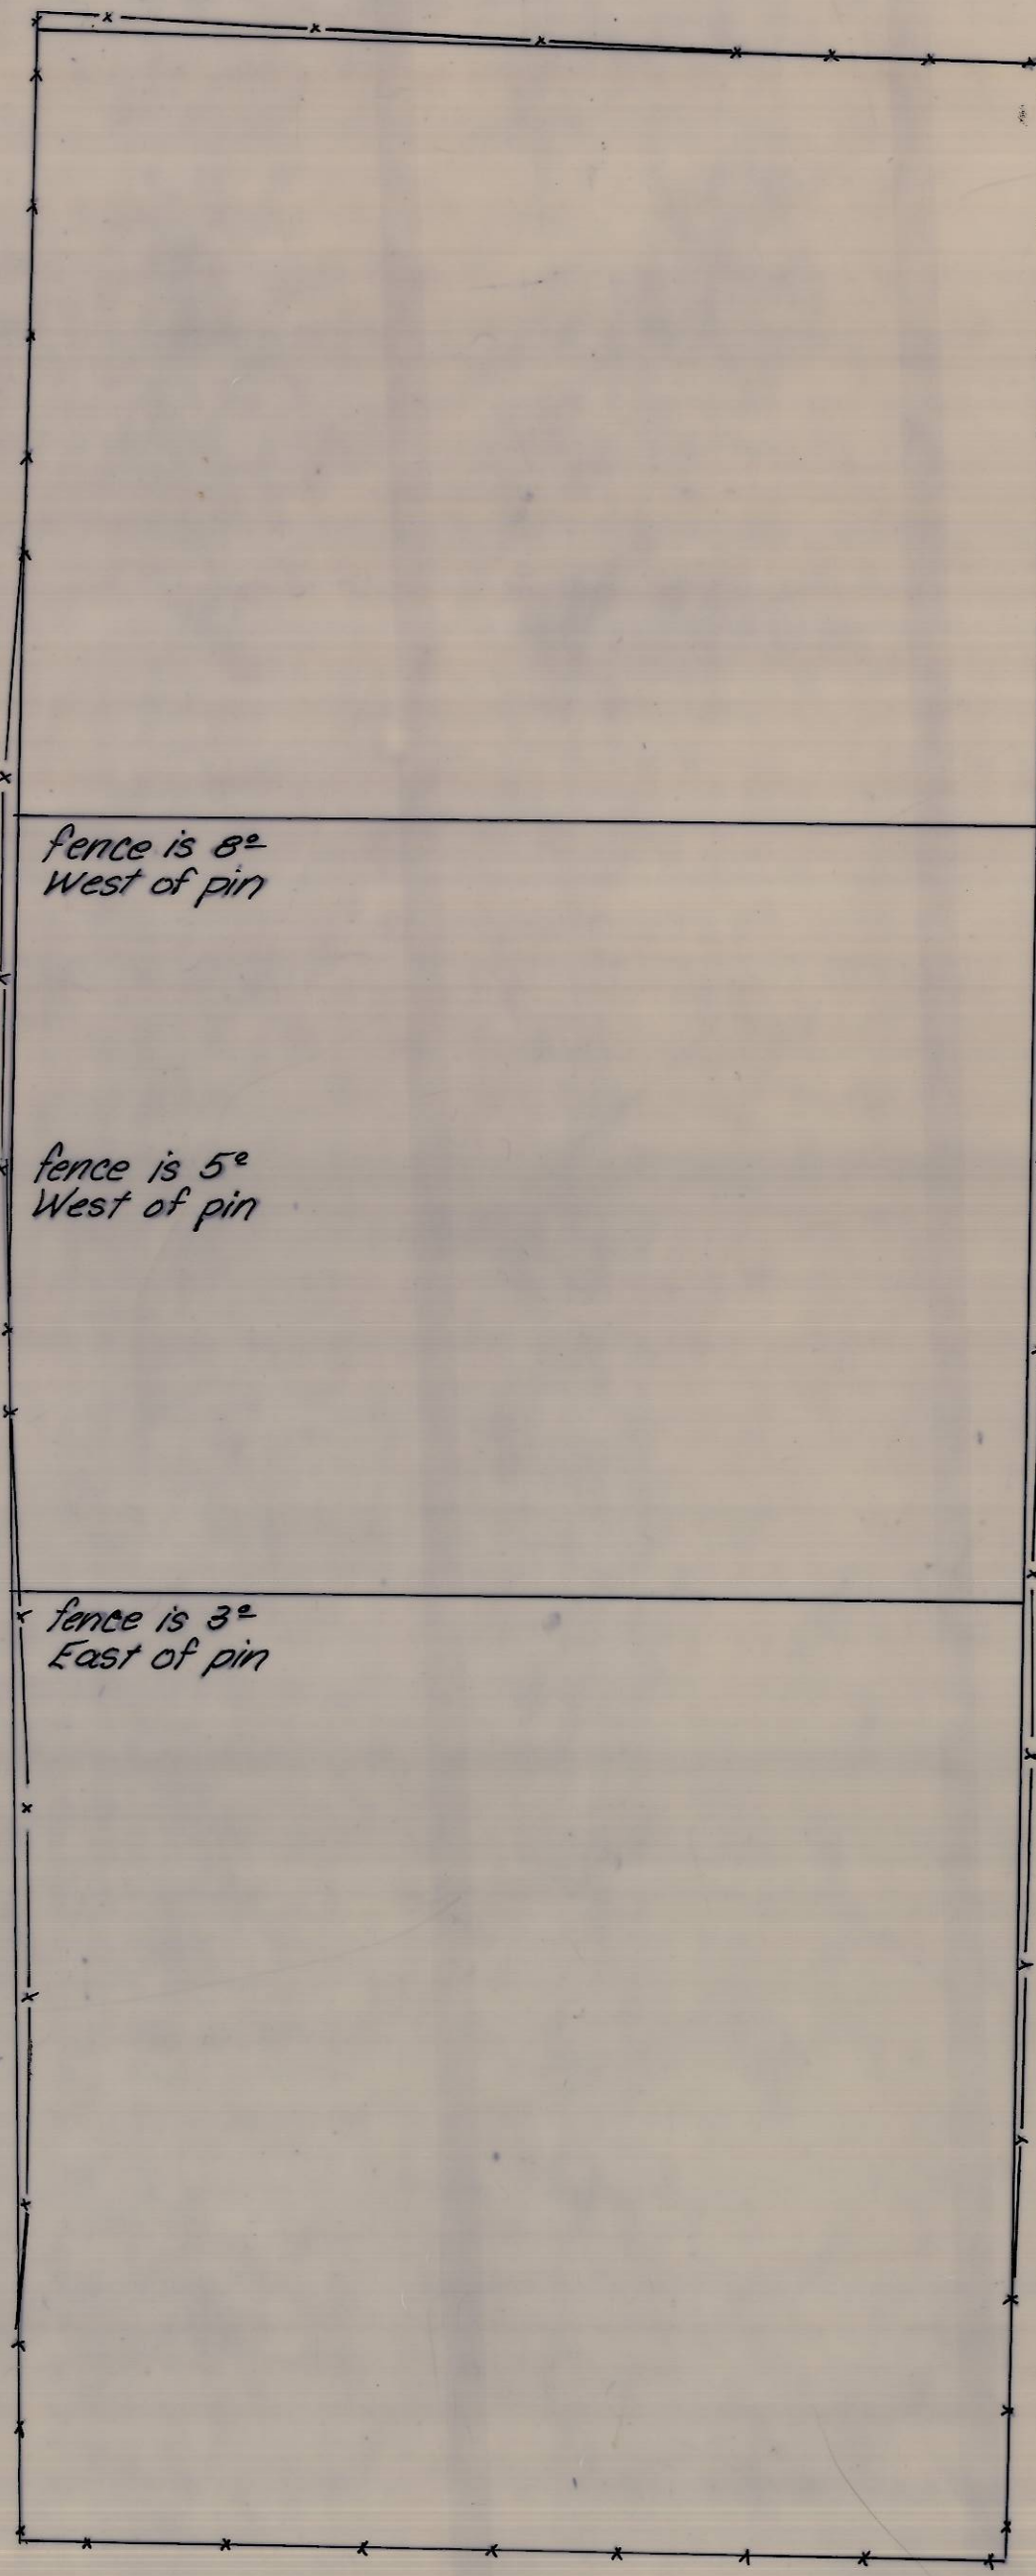

FENCE DETAIL
11.7.9

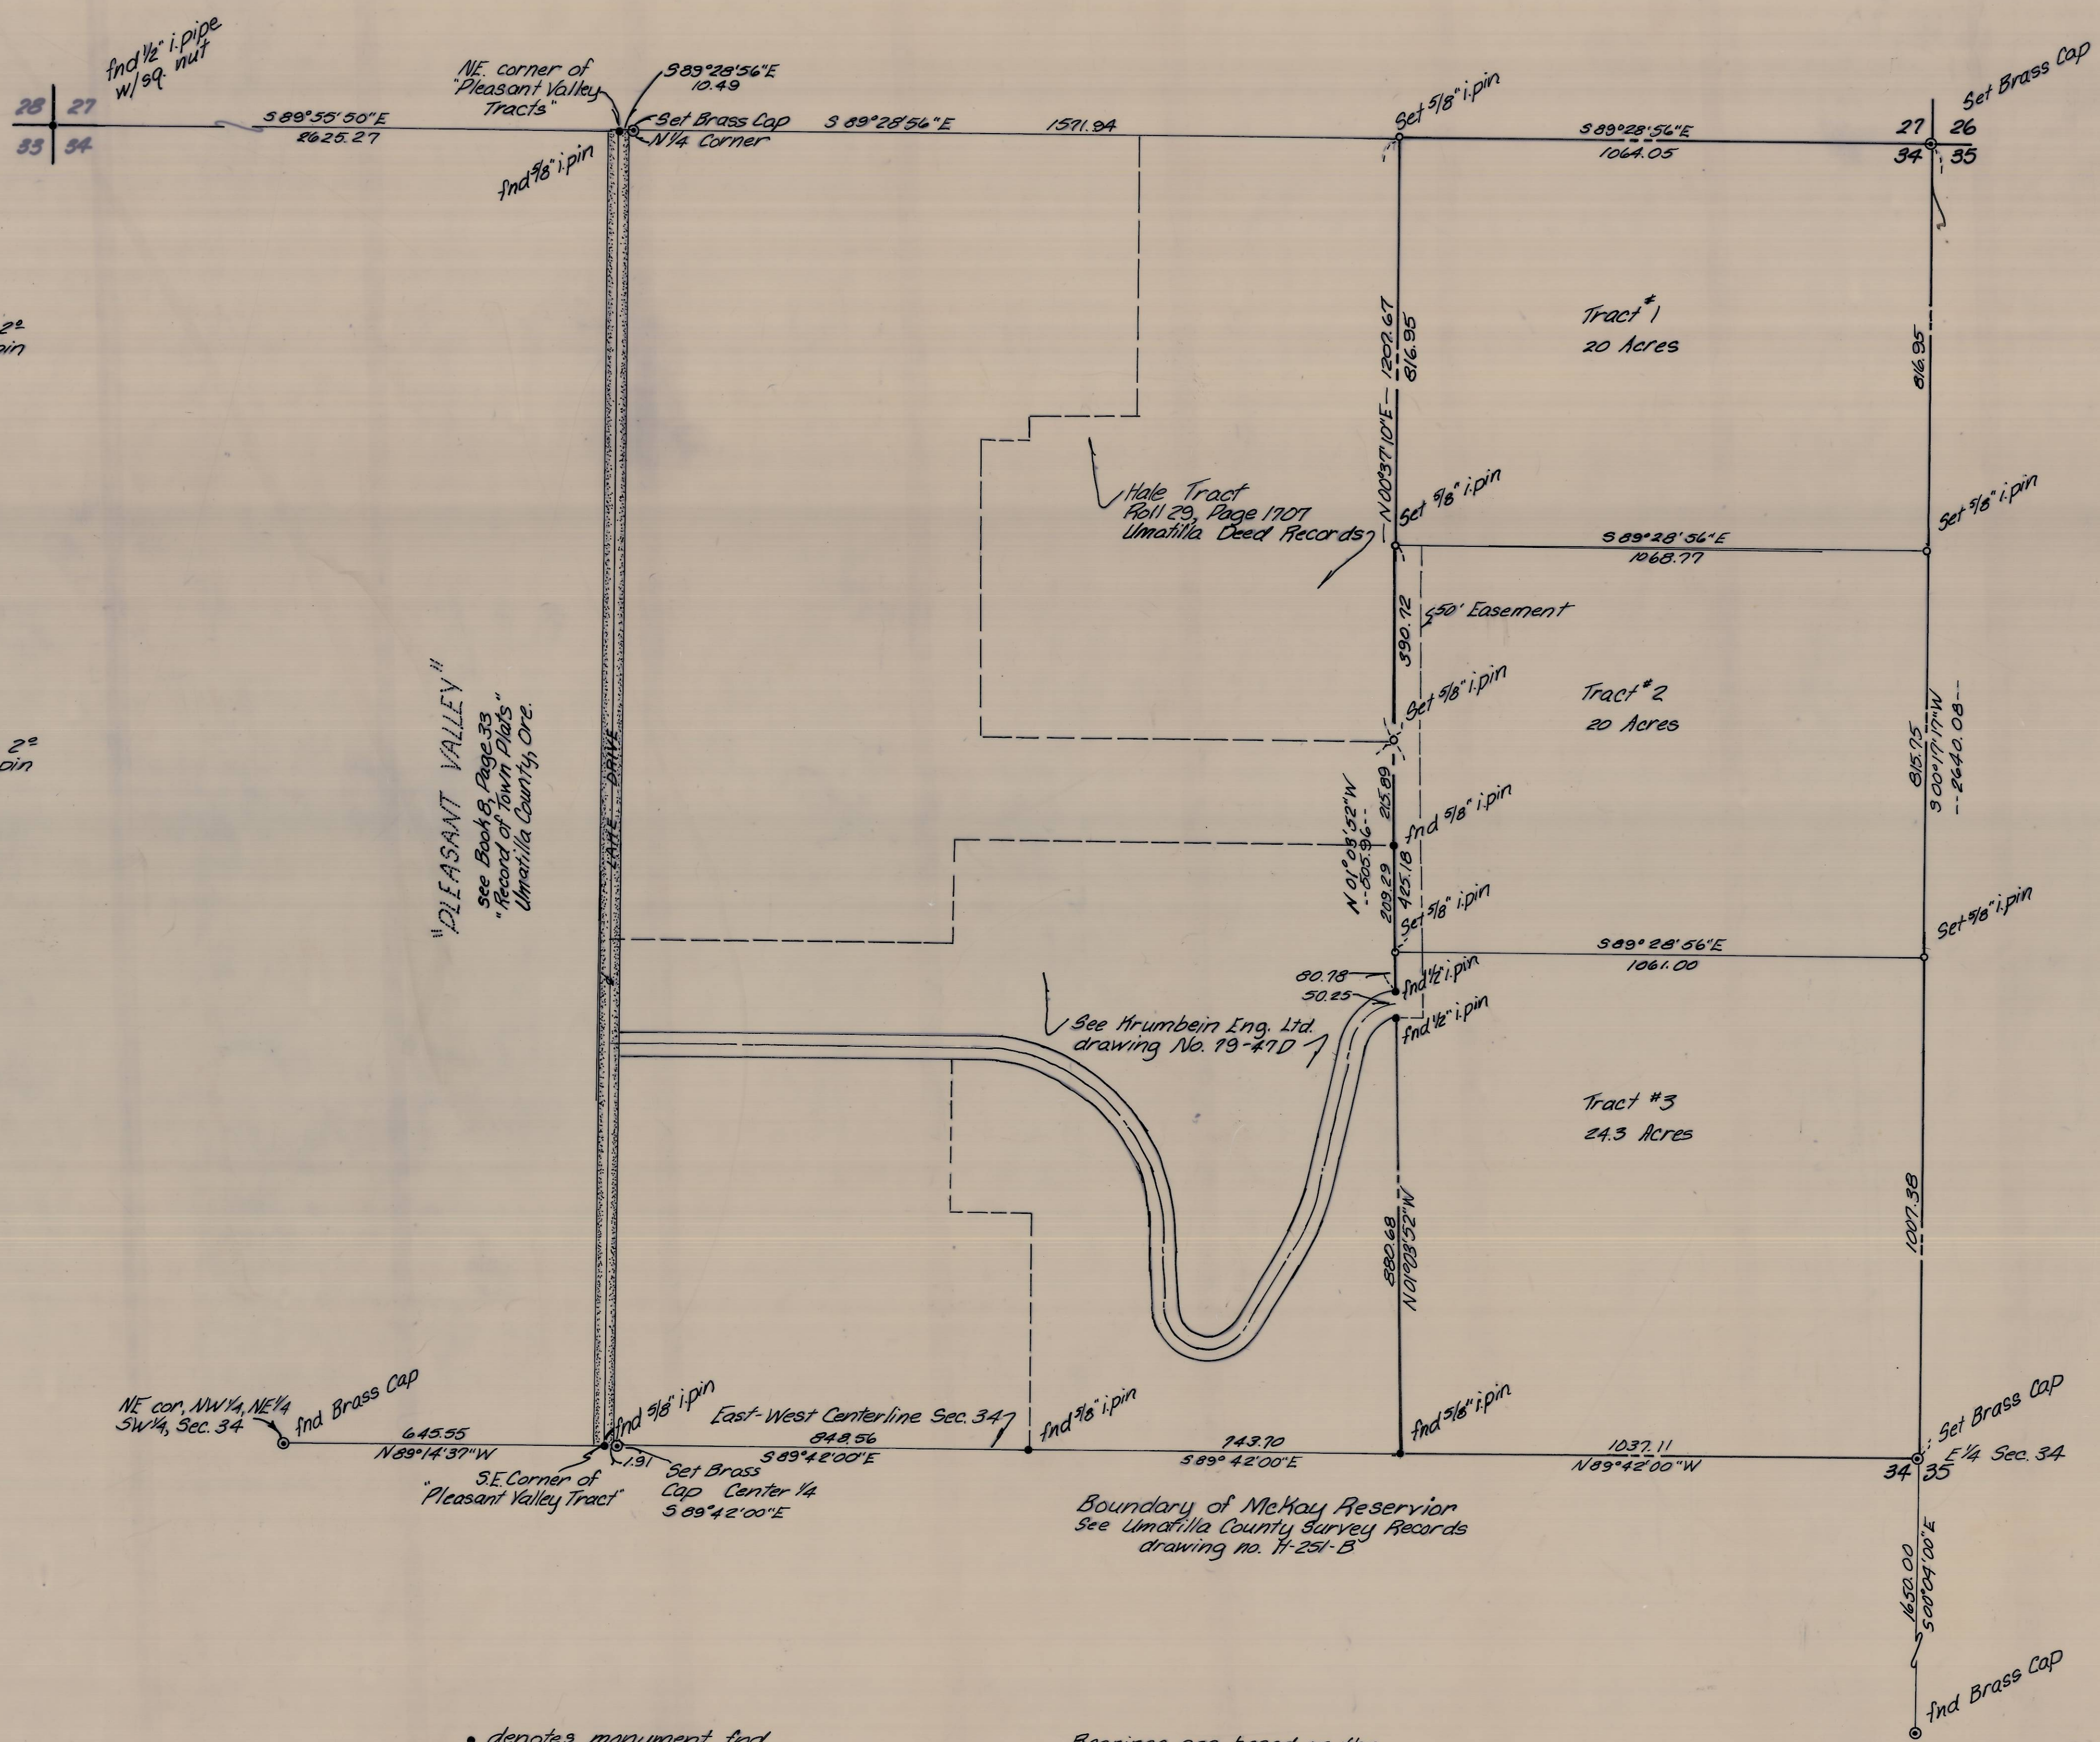

"PLEASANT VALLEY"
See Book 8, Page 33
"Record of Town Plats"
Umatilla County, Ore.

Boundary of McKay Reservoir
See Umatilla County Survey Records
drawing no. 11-251-B

- denotes monument found as shown
- denotes monument set as shown
- ⊙ denotes Brass Cap

Bearings are based on the East-West Centerline of Section 34, T2N, R32E, W.M. as per Umatilla County Survey Records drawing no. 11-251-B.



RECEIVED BY
Umatilla County Surveyor
Date 5-1-80
Rec'd by ECS
A-98-C

David Hill
Professional Engineer

KRUMBEIN ENGINEERING CO
ENGINEERS - SURVEYORS - PLANNERS
221 S. Main, Pendleton, Oregon
Survey for
TOM BURTON
descriptive parcel in NE 1/4, Sec. 34, T2N, R32E

SCALE 1" = 200'
DATE 3-20-80
DRAWN BY M.L.J.
OK'D BY G.F.B.
DRWG. NO. 80-5D