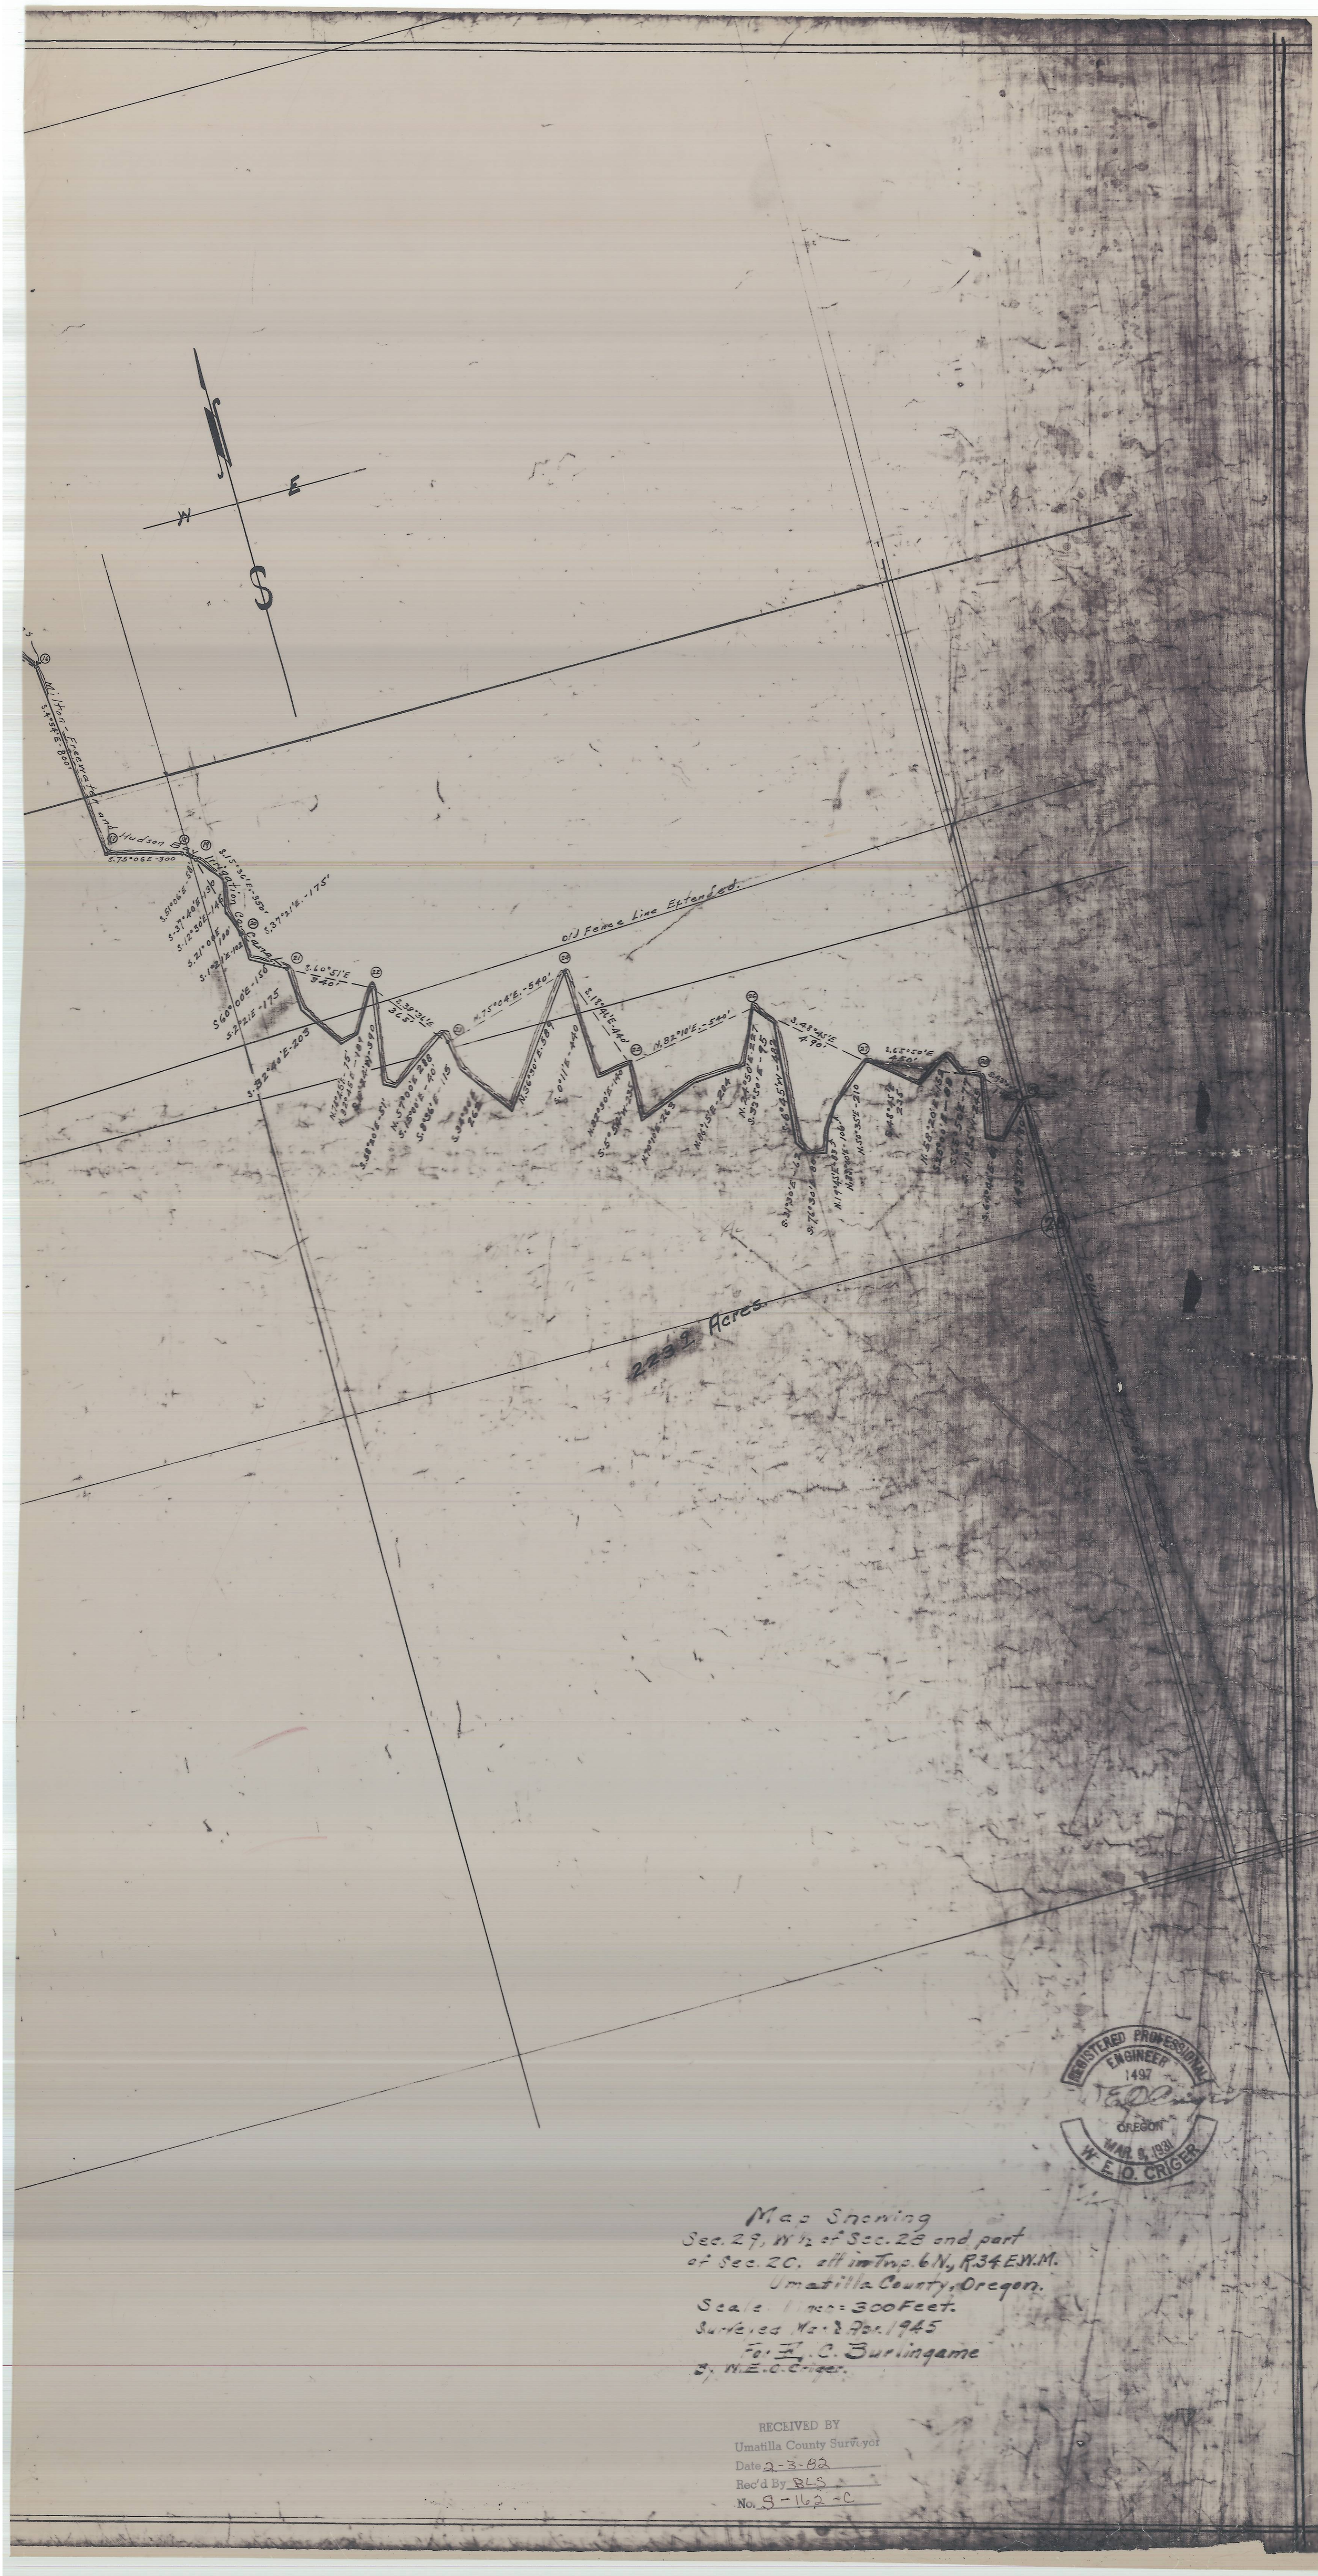

REGISTERED PROFESSIONAL ENGINEER
1497
OREGON
MAR. 8, 1981
W. E. O. CRIGER

Map Showing
Sec. 29, W½ of Sec. 28 and part
of Sec. 20, all in Twp. 6 N, R 34 E.W.M.
Umatilla County, Oregon.
Scale 1 inch = 300 Feet.
Surveyed Mar. & Apr. 1945
For H. C. Burlingame
By W. E. O. Criger.

RECEIVED BY
Umatilla County Surveyor
Date 2-3-82
Rec'd By RLS
No. S-1162-C

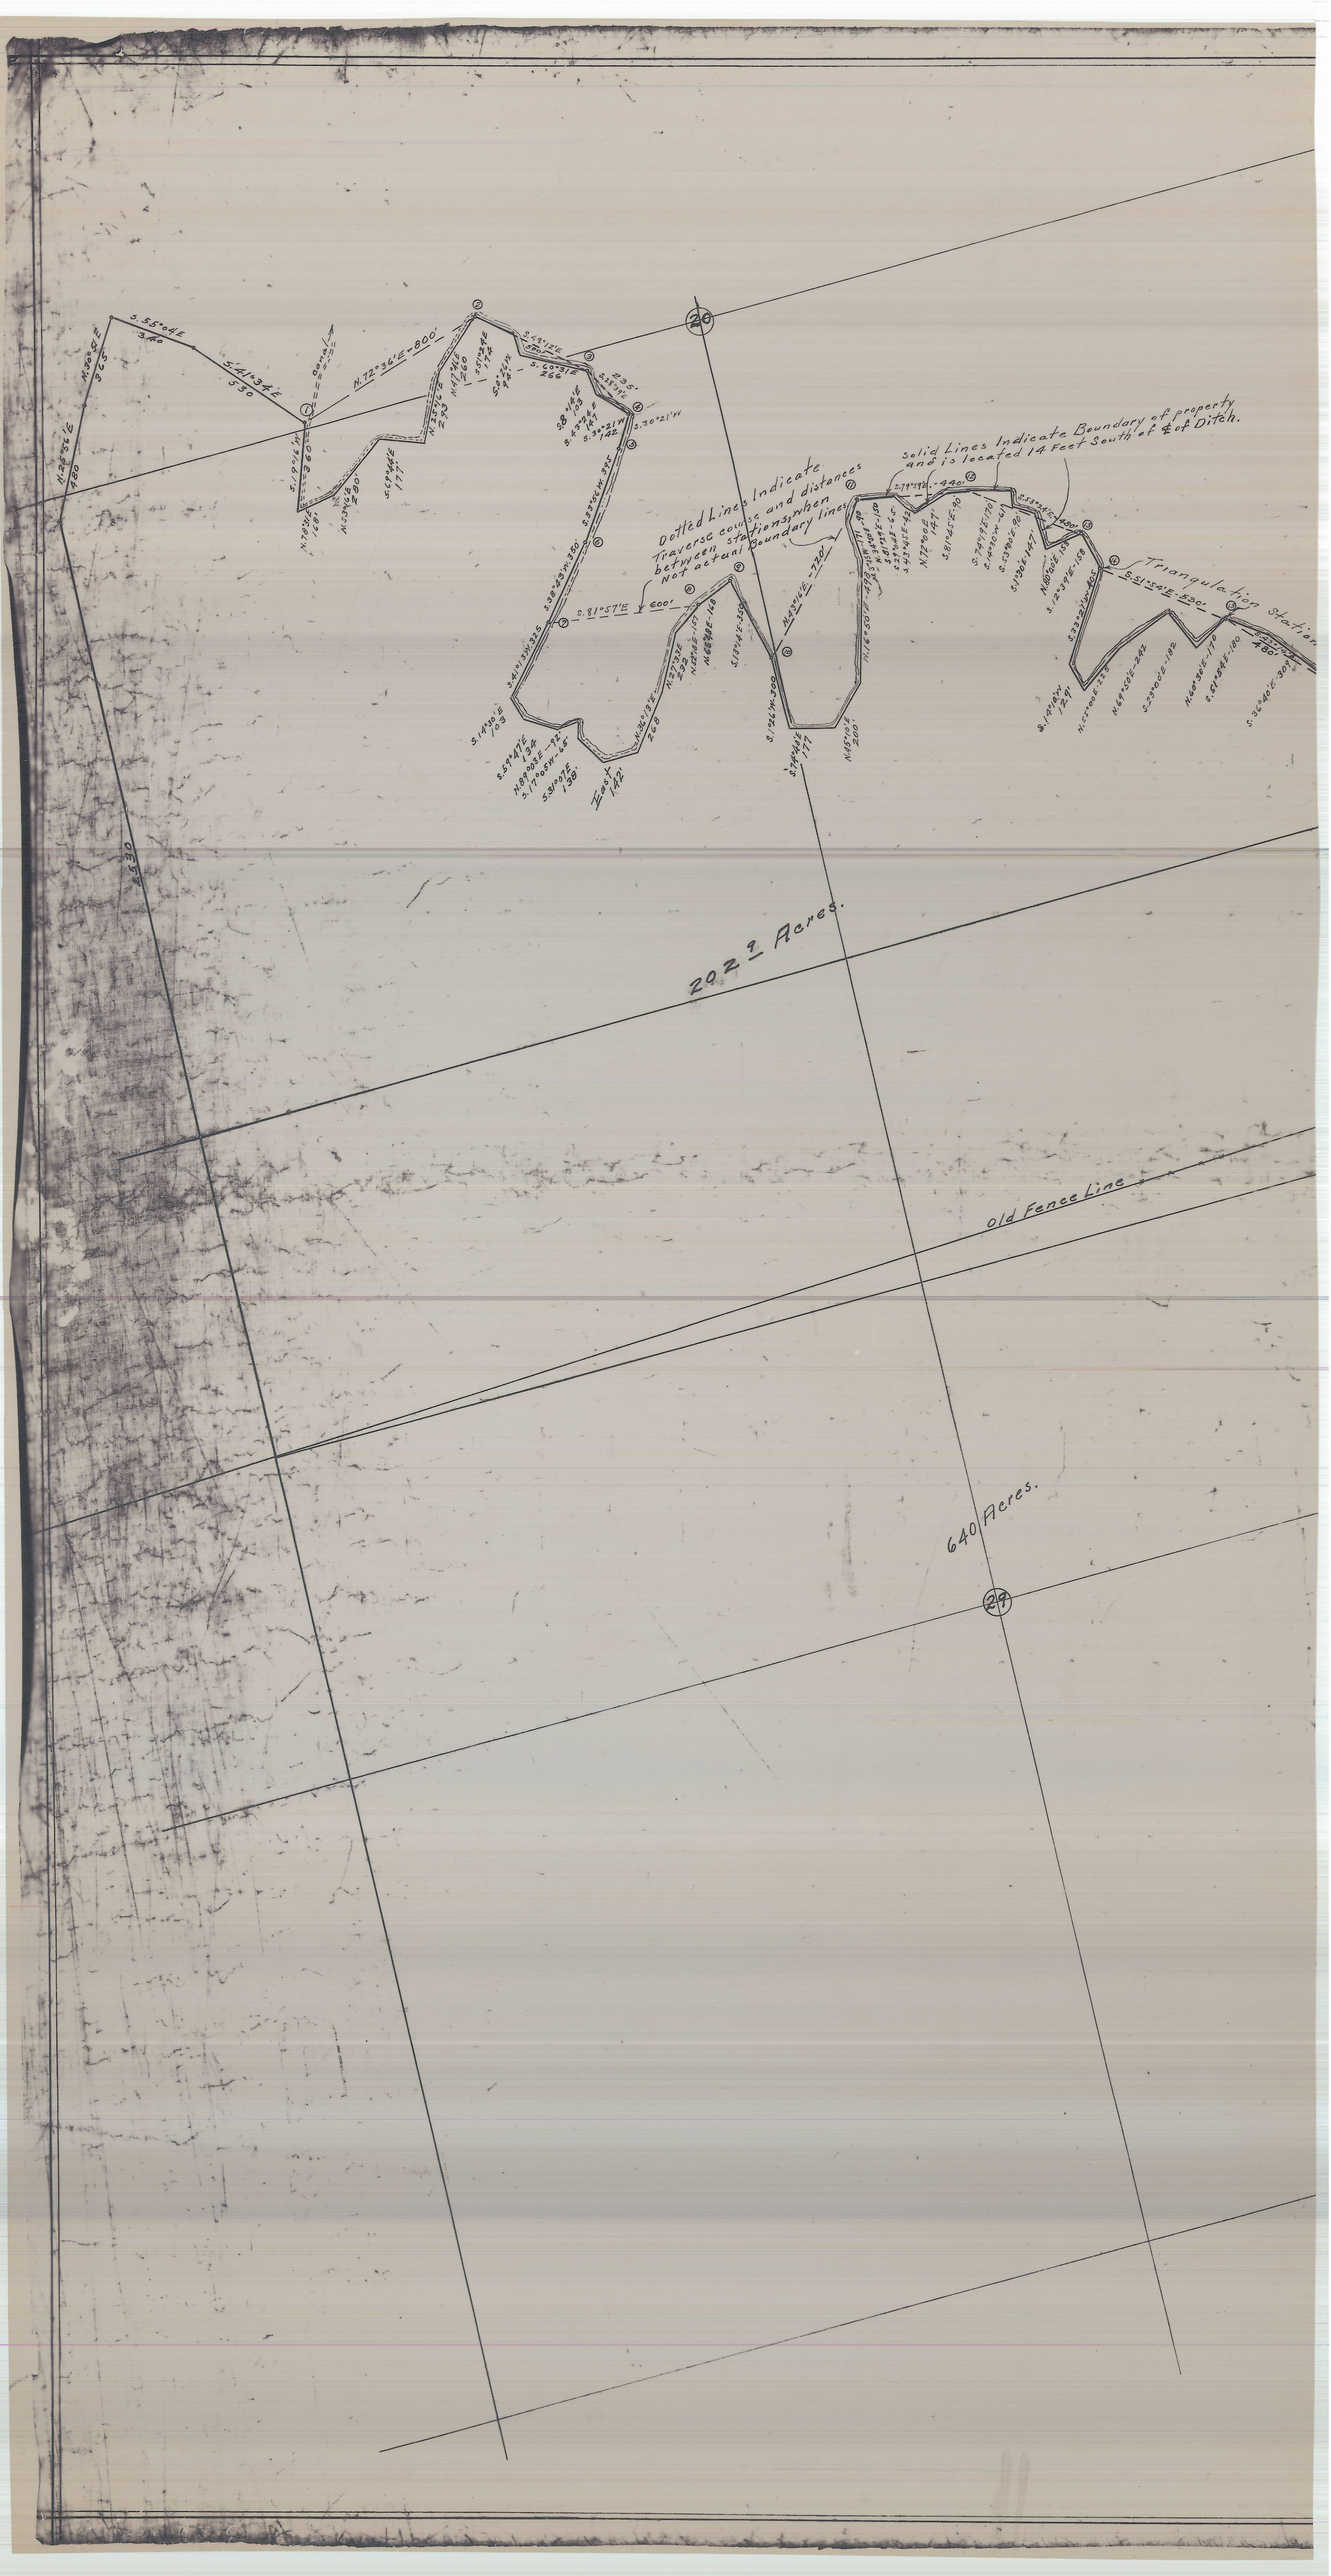

20
Dotted Lines Indicate Traverse course and distances between stations, when Not actual Boundary lines
Solid Lines Indicate Boundary of property and is located 14 Feet South of ℄ of Ditch.
Triangulation Station
202.9 Acres.
Old Fence Line
640 Acres.
29