


Plot of County Road from near Jas. Humphreys Ranch
30

Intersection of County Road leading from Umatilla City
to Sailys Ranch on Blue mts.

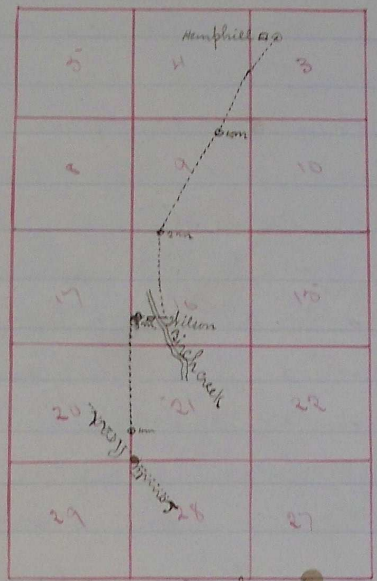

Course	Distance Chains	Remarks
S 33 1/2° W	30	
S 26° W	50	1 mile near Phipps Ranch
S 30° W	50	2 miles " Humphreys "
S 11° W	23	
S 2° E	12	
S 11° E	20	
West	19	3 miles near O.H. Wilsons Store
West	2	
South	78	4 m Wilsons Ranch
South	20	to junction with county road

Pendleton July 1st 1870

I do hereby certify that the above is a true copy of the field notes of the road surveyed by me under direction of the viewers F. A. Shields & Mr. Moynett & by order of County Court accompanying which is a plat of the same as taken from the field notes.

Chairman { Dick Stewart 3/4
 { Jas. S. Smith 3/4

J. H. Sharon
Surveyor

Pendleton July 5th 1870

To the Hon. Co. Court Umatilla County Oregon

We the viewers appointed at the April Term of said Court to view out and survey a road from Humphreys to intersect the Co Road leading from Umatilla to the Blue Mountains proceeded with the County Surveyor to view out and survey the same according to instruction and would beg leave to recommend the location of the same as a public benefit.

F. A. Dackell
F. Moynett
Johnston Thompson

Recorded Nov 20th 1878

J. B. Kumpy Co. Clerk

By J. H. Sharon Deputy