Rd #1

Plat of Road from Umatilla City
30
Blue Mts. via McKay Cr.

(Continued)

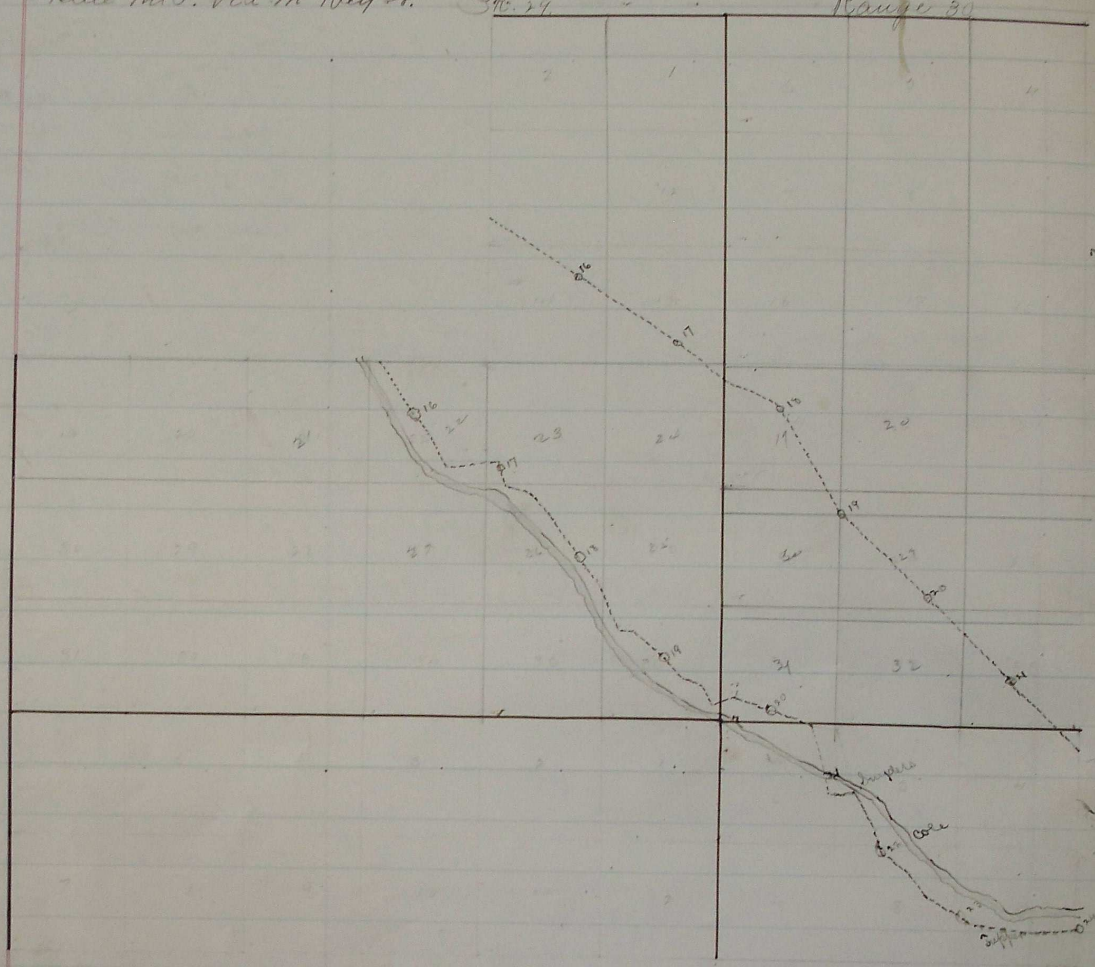

(continued p. 9.)