


Plat of Road from Unalaska City  
Blue Mt. via McKee Creek

Continued


Rd #1

Range 30

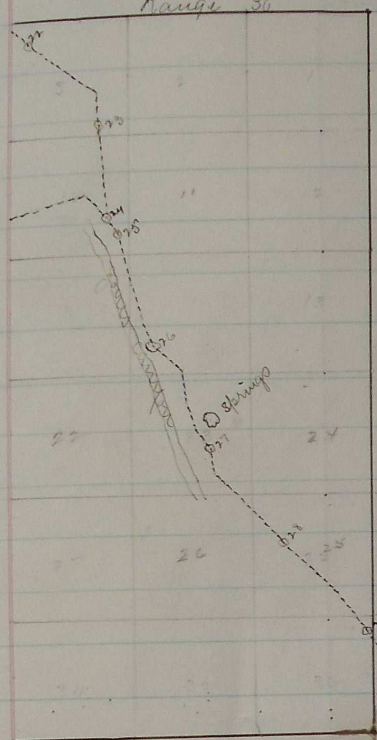

S/P  
A.

Range 31

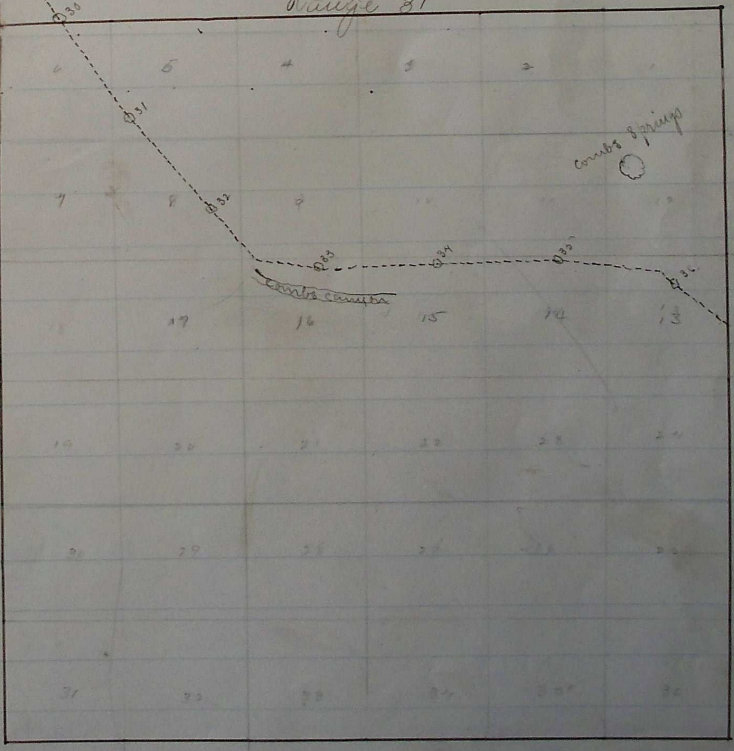

Crests Springs

Crests corner

Base line

Township  
3 N

Township  
1 N

Continued p. 12