


Rd #11
 26 in. in diameter angle to S. 28 E. 52 R. A.P. S. 35 E. 36 R. A.P. S. 34 E. 146
 R. A.P. S. 22 E. 62 R. For the 25th mile post a yellow fir tree diameter 20 in
 angle to S. 27 E. 22 A.P. S. 67 N. 32 R. A.P. S. 45 E. 86 R. A.P. S. 35 W. R. A.P.
 S. 58 E. 30 R. A.P. N. 67 E. 24 R. For 26th mile post a white fir tree 7 in.
 in diameter angle to N. 58 E. 52 R. A.P. N. 65 E. 08 R. A.P. S. 52 E. 102 R. A.P.
 S. 12 E. 02 R. A.P. S. 43 E., the 27th mile post on fir stump on large grade
 bearing tree white fir diameter 87 in. course S. 15 E. distant 33 links
 Bearing tree yellow fir diameter 39 in. course S. 34 W. distant 25
 links continue same course 74 R. A.P. S. 30 E. 143 R. to summit of Blue
 mountains Post at termination of road Pine tree 7 inches in diameter
 general course of road S. 41 E.

I hereby certify that the accompanying plat is correct according to field notes also that the foregoing is a correct copy of field notes taken from survey and measurement of the proposed county Road Plat of Road from State line }
 Blue Mts. }
 Wm. Willis
 Surveyor.

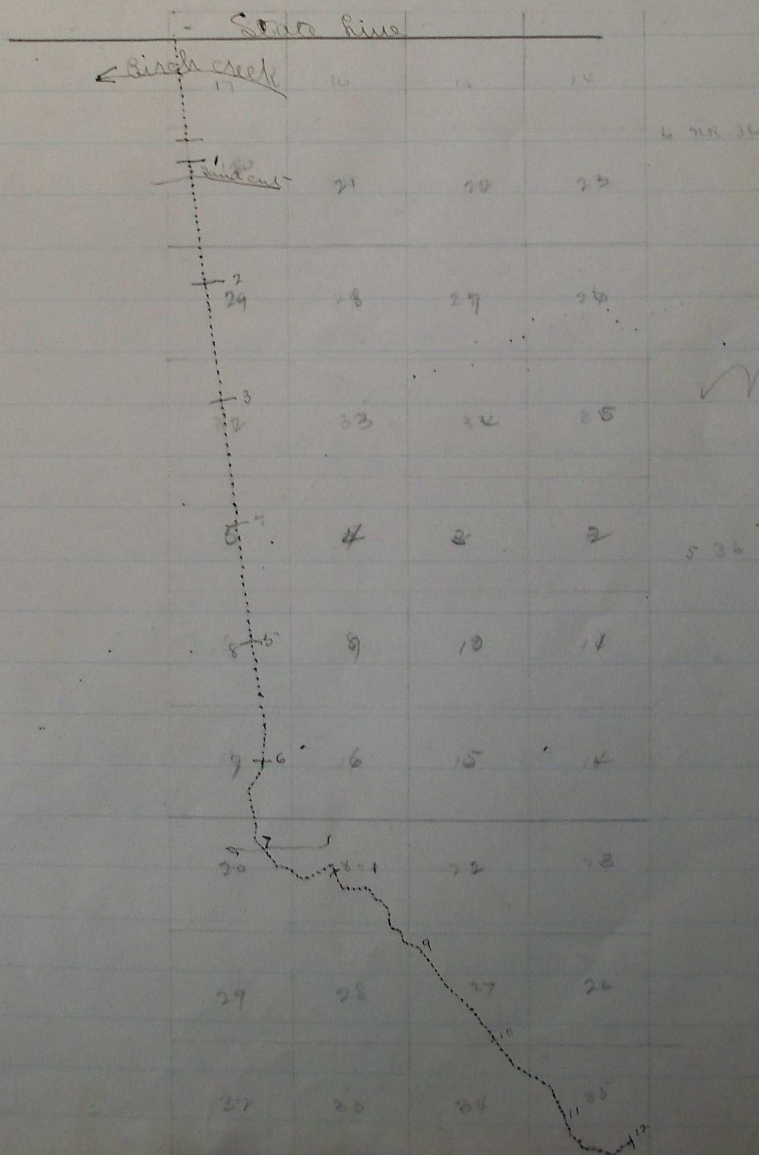

(continued page 20)